


LABOR AND MATERIALS

1	Copper	} Connection	1"	\$
	Lead			
1	Curb	} Cock Valve T.S. & V.	1/4 in. Oriseal	\$
1	Service box	} Short 3 1/2 x 4 1/2	Oriseal	\$
	Old returned			
			Buff or Rdway	\$
17	Ft. 1/4 in.	} Copper C.I. C.I.	Pipe at	\$
	Nipples	in. at		\$
	Bushings	to in. at		\$
1	Red'g	} Coupl'gs	to in. at	\$
	Ine'g			
1	Union	1/4 in. at	Male Adapter	\$
	Meter	in. at		\$
	Lead Joints at			\$
	Compound Joints at			\$
	Maintenance Foreman			\$
	Hrs. Water Maint. Man-1 at			\$
	Hrs. Water Maint. Man-2 at			\$
	Hrs. Garage Foreman at			\$
	Hrs. Labor at			\$
	Hrs. Compressor at			\$
	Compensation Ins. at \$		per C	\$
	Trucking			\$
	Pav't Patch			\$
	Tap by Larrau		Co.	\$
				\$
			10-14-70.	\$
	O'head			\$
				\$

St. Pl. Ave. No. 1

Hofman
Name of Owner
Jack - Park Realty.

Labor and Mat'l. Report Oct. 14 1970

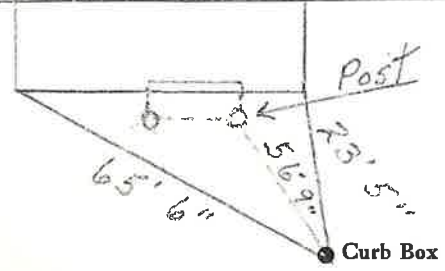

4" Main Elev. of Main at tap 6'

Gate at • Gate at •

• Curb Box

Labor and Materials


1	Copper	Connection	1"	\$	3.81
1	Curb	Cock Valve	1" in.	\$	3.59
		T.S. & V.			
1	Service Box	Short 3/4" x 1/2"		\$	1.55
	Old returned	Long 4 1/2" x 5 1/2"			
		Buff. on Rdway			
16	Ft.	Copper	Pipe at 1"	\$	6.96
		Galv. Iron			
		Cast Iron			
	Nipples	in. at		\$	
	Bushings	to in. at		\$	
1	Red'g Inc'g	Couplings	1" to 1 1/4" in. at	\$	30
	Union	in. at		\$	
	Meter	in. at		\$	
	Lbs. Br. Stone	at		\$	
	Lbs. Sand	at		\$	
	Bags Cement	at		\$	
	Paving Brick	Mack Red Asphalt	at	\$	
	Lead Joints	at		\$	
	Leadite Joints	at		\$	
4	Hrs. Foreman	at		\$	3.75
16	Hrs. Common Labor	at		\$	7.20
	Hrs. Common Labor	at		\$	
	Hrs. Mason	at		\$	
	Hrs. Mason's Helper	at		\$	
2	Hrs. Compressor	at		\$	3-
	Compensation Ins			\$	34
	Trucking			\$	1-
	Builders' Use of Water			\$	25-
				Total \$	56.50

30-64

Labor and Material Report

6/23

1930

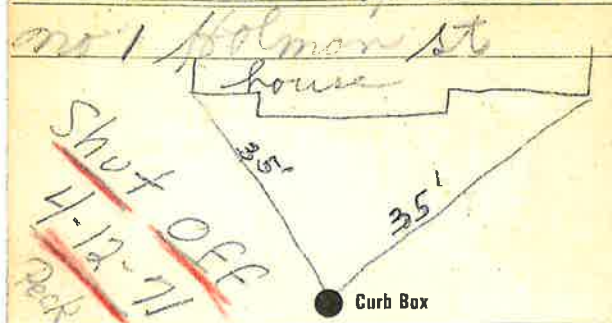

4" Main

Elev of Main at tap 5'

Gate at ●

● Gate at

● Curb Box

Old Tap shut off

1" TAP TO Be Dug at main