

Labor and Materials

1	Copper Lead	Connection	3/4	\$ 2.60
1	Curb	Cock Valve T.S. & V.	3/4 in.	\$ 2.30
1	Service Box Old returned	Short 3/4 x 1/2 Long 4 1/2 x 5 1/2	Buff or Rdway	\$ 1.50
9	Ft.	3/4 in.	Copper Galv. Iron Cast Iron Pipe at	\$ 2.39
	Nipples	in. at		\$
	Bushings	to in. at		\$
	Red'g Inc'g	Couplings	to in. at	\$
	Union	in. at		\$
	Meter	in. at		\$
	Lbs. Br. Stone	at		\$
	Lbs. Sand	at		\$
	Bags Cement	at		\$
	Paving Brick	Mack Red Asphalt	at	\$
	Lead Joints	at		\$
	Leadite Joints	at		\$
7	Hrs. Foreman	at		\$ 4.38
8	Hrs. Common Labor	at		\$ 3.25
	Hrs. Common Labor	at		\$
	Hrs. Mason	at		\$
	Hrs. Mason's Helper	at		\$
1	Hrs. Compressor	at		\$ 1.50
	Compensation Ins.			\$ 2.4
	Trucking			\$ 1.50
	Builders' Use of Water	Patch		\$ 25.00
	Total			\$ 44.16


29-165

Labor and Material Report

12

1929

2 Holmes St.

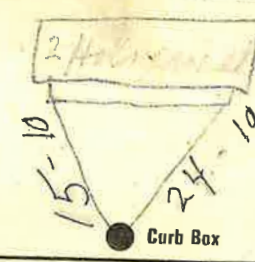

4 Main

Elev of Main at tap 56.42

Gate at ● TAX ID # 302.20-15-11 ● Gate at

● Curb Box
Old tap about off

TAX ID # 302.20-15-11