

LABOR AND MATERIALS


3/4 Copper } Connection _____ \$ _____
 Lead }
 Curb } Cock _____ in. _____ \$ _____
 Valve }
 T.S. & V. }
 Service box { Short 3-1/2 x 4-1/2 } _____ \$ _____
 Old returned { Long 4-1/2 x 5-1/2 }
14 Ft. 8 in. } Copper } Pipe at _____ \$ _____
 G.I. }
 C.I. }
 Nipples _____ in. at _____ \$ _____
 Bushings _____ to _____ in. at _____ \$ _____
 Red'g _____
 Inc'g _____
 Union _____ in. at _____ \$ _____
 Meter _____ in. at _____ \$ _____
 _____ \$ _____
 Compound Joints at _____ \$ _____
 Maintenance Foreman _____ \$ _____
 Hrs. Water Maint. Man - 1 at _____ \$ _____
 Hrs. Water Maint. Man - 2 at _____ \$ _____
 Hrs. Garage Foreman _____ at _____ \$ _____
 Hrs. Labor _____ at _____ \$ _____
 Hrs. Compressor at _____ \$ _____
 _____ \$ _____
 Trucking _____ \$ _____
 Pav't Patch _____ \$ _____
 _____ \$ _____
 _____ \$ _____
 _____ \$ _____
 _____ \$ _____

Holman

St. #79
 Pl. Ave No.

Name of Owner

Labor and Mat'l. Report 10 3-20-12
 New Line

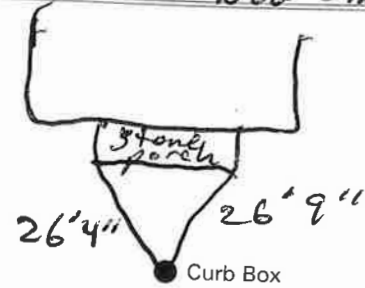

4'' Main Elev. of Main at tap 6'
 Gate at ● Gate at ●

● Curb Box

#9 TAX ID # 302.20-14-3

