


LABOR AND MATERIALS

1	Copper	} Connection	3/4"	\$ 2.71
	Lead			
1	Curb	} Cock Valve T. S. & V.	3/4 in.	\$ 3.83
1	Service Box			
	Old returned			
		} Short 3 1/2 x 4 1/2 Long 4 1/2 x 5 1/2 Buff. or Rdway		\$ 4.69
7	Ft. 3/4 in.			
		} Copper Galv Iron Cast Iron	Pipe at	\$ 3.15
	Nipples			
	Bushings			
	Red'g Inc'g	} Couplings	to in. at	\$
	Union			
	Meter	in. at	\$	
	Lead Joints	at	\$	
	Leadite Joints	at	\$	
	Hrs. Foreman	at	\$	
	Hrs. Chauffeur	at	\$	
1	Hrs. Tapper	at Main Man V	\$ 1.24	
1	Hrs. Labor	at	\$ 1.13	
	Hrs. Labor	at	\$	
	Hrs. Compressor	at	\$	
	Compensation Ins.	5686	\$ 13	
	Trucking		\$ 1.50	
	Builders Use of Water	patch	\$ 8.96	
	Tap by Gissard & Co		\$	
	12-13-55		\$	
			\$	
			\$	
			\$	
			\$ 27.34	

St. Pt. Ave. No. 8

Helman
Name of Owner Mulcahy

Labor and Mat'l. Report Dec. 13 1955

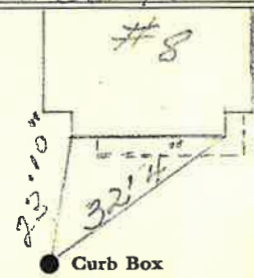

4" Main Elev. of Main at tap 4'

Gate at ● Gate at ●

● Curb Box

TAX ID # 302.20-15-8