

LABOR AND MATERIALS

| | | | | | | |
|-----------------------|----------------|-----------------------|-----------------|---------------------|----|----|
| Copper | } | Connection | | | \$ | |
| Lead | | | | | | |
| Curb | } | Cock Valve T. S. & V. | | in. | \$ | |
| Service Box | | | } | Short 3 1/2 x 4 1/2 | | \$ |
| Old returned | | | | Long 4 1/2 x 5 1/2 | | |
| | Buff. or Rdway | | | | | |
| Ft. _____ in. | } | Copper | Pipe at | | \$ | |
| | | Galv Iron | | | | |
| | | Cast Iron | | | | |
| Nipples | | in. at | | | \$ | |
| Bushings | | to _____ in. at | | | \$ | |
| Red'g Inc'g | } | Couplings | to _____ in. at | | \$ | |
| | | | | | | |
| Union | | in. at | | | \$ | |
| Meter | | in. at | | | \$ | |
| Lead Joints | | at | | | \$ | |
| Leadite Joints | | at | | | \$ | |
| Hrs. Foreman | | at | | | \$ | |
| Hrs. Chauffeur | | at | | | \$ | |
| Hrs. Tapper | | at | | | \$ | |
| Hrs. Labor | | at | | | \$ | |
| Hrs. Labor | | at | | | \$ | |
| Hrs. Compressor | | at | | | \$ | |
| Compensation Ins. | | | | | \$ | |
| Trucking | | | | | \$ | |
| Builders Use of Water | | | | | \$ | |
| | | | | | \$ | |
| | | | | | \$ | |
St. _____
 -Pl. _____
 Ave. No. 13

Holman

Name of Owner _____

Labor and Mat'l. Report 1944

?


_____ Main

Gate at ●


Elev. of Main at tap _____

● Gate at

try

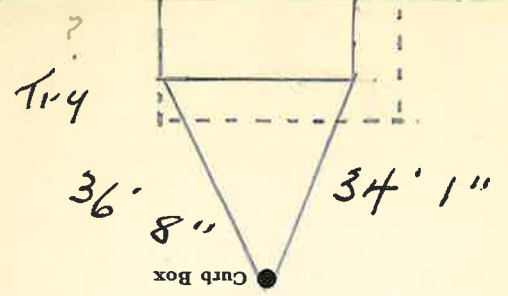

Gate at ● Gate at ●
 Main Main
 Elev. of Main at tap

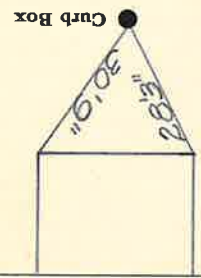

Labor and Mat'l. Report 19 14

Name of Owner

St. Pt. Ave. No. 13
 Holman