


LABOR AND MATERIALS

1	Copper	} Connection	3/4	_____	\$ _____				
	Lead								
1	Curb	} Cock Valve T.S. & V.	} 3/4 in.	_____	\$ _____				
1	Service box					} Short 3 1/2 x 4 1/2	}	_____	\$ _____
	Old returned								
9	Ft.	} Copper	} 3/4 in.	} Pipe at _____	\$ _____				
						} C.I.	}		
		} C.I.	}						
	Nipples	in. at _____			\$ _____				
	Bushings	to _____ in. at _____			\$ _____				
1	Red'g	} Coupl'gs	} 3/4	} to _____ in. at _____	\$ _____				
	Ind'g								
	Union	in. at _____			\$ _____				
	Meter	in. at _____			\$ _____				
	Compound Joints	at _____			\$ _____				
	Maintenance Foreman	_____			\$ _____				
	Hrs. Water Maint. Man—1	at _____			\$ _____				
	Hrs. Water Maint. Man—2	at _____			\$ _____				
	Hrs. Garage Foreman	_____ at _____			\$ _____				
	Hrs. Labor—	_____ at _____			\$ _____				
	Hrs. Compressor	at _____			\$ _____				
	Trucking	_____			\$ _____				
	Pav't Patch	_____			\$ _____				
					\$ _____				
					\$ _____				
					\$ _____				
					\$ _____				

HOPE St. No. 4  
 Ave. No. 4

Name of Owner \_\_\_\_\_

Labor and Mat'l. Report \_\_\_\_\_

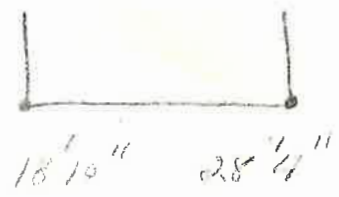

● Curb Box

6" Main Elev. of Main at tap 5'

Gate at ● Gate at ●

● Curb Box

TAX ID # 302.16-6-13

18' 10"

28' 4"