

Labor and Materials


..+..Copper } Connection.....	\$ 1.25
..+..Lead- }	
..+..Curb { Cock Valve }	in	\$ 1.70
..+..Service Box { Short 3 1/2 x 4 1/2 }	\$ 1.37
..+..Old returned { Long 4 1/2 x 5 1/2 }	
..+..3 ft. 3/4 in. { Copper Galv. Iron } Pipe at 13 1/2	\$ 4.19
..+..Cast Iron }	
..+..Nipples	in. at	\$
..+..Bushings	to	in. at
..+..Red'g Inc'g } Couplings.....	to	in. at
..+..Union.....	in. at	\$
..+..Meter.....	in. at	\$
..+..Lbs. Br. Stone at		\$
..+..Lbs. Sand at		\$
..+..Bags Cement at		\$
..+..Paving Brick { Mack Red Asphalt } at		\$
..+..Lead Joints at		\$
..+..Leadite Joints at		\$
..+..4 Hrs. Foreman at	67 1/2	\$ 2.50
..+..8 Hrs. Common Labor at	50	\$ 4.00
..+..12 Hrs. Common Labor at	45	\$ 5.40
..+..Hrs. Mason at		\$
..+..Hrs. Masons Helper at		\$
..+..Hrs. Compressor at		\$
..+..Compensation Ins		\$ 45
..+..Trucking		\$ 1.00
..+..Builders Use of Water ... Patch		\$ 5.00
Total		\$ 26.96

1935-58

Labor and Material Report

May 31 1935

10 Horicon Ave

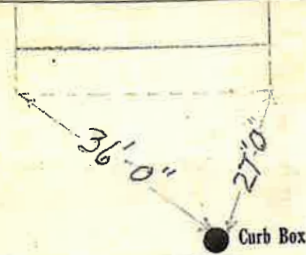

6 Main

Elev. of Main at tap

Gate at

TAX ID # 302.15-7-8

Gate at

● Curb Box

old shut off at main

[Handwritten signature]