

LABOR AND MATERIALS

1 Copper } Connection $\frac{3}{4}$ \$
 Lead }
 1 Curb { Cock } $\frac{3}{4}$ or seal in. \$
 Same { Valve }
 { T. S. & V. }
 Service Box { Short $3\frac{1}{2} \times 4\frac{1}{2}$ } \$
 Old returned { Long $4\frac{1}{2} \times 5\frac{1}{2}$ }
 { Buff. or Rdway }
 30 Ft. $\frac{3}{4}$ in. { Copper } Pipe at \$
 { Galv. Iron }
 { Cast Iron }
 Nipples in. at \$
 Bushings to in. at \$
 Red'g } Couplings to in. at \$
 Inc'g }
 Union in. at \$
 Meter in. at \$
 Lead Joints at \$
 Leadite Joints at \$
 Hrs. Foreman at \$
 Hrs. Chauffeur at \$
 Hrs. Tapper at \$
 Hrs. Labor at \$
 Hrs. Labor at \$
 Hrs. Compressor at \$
 Compensation Ins. \$
 Trucking \$
 Builders Use of Water \$
 Tap by Gifford & Co. \$
 2-26-64, \$
 \$
 \$

St.
 Ph.
 Ave. No. 16


HORIZON

Name of Owner

IMPIE

Labor and Mat'l. Report

Feb. 26 1964

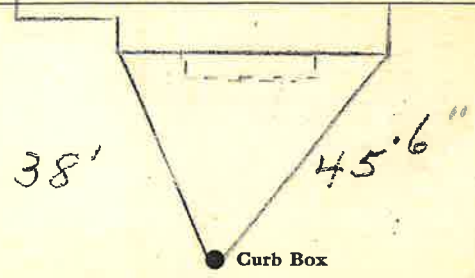

6" Main Elev. of Main at tap 5'

Gate at ● Gate at ●

● Curb Box