


### Labor and Materials

1	Iron Connection	3/4"	at	\$
	Curb Cock		at	\$
1	Service Box	Short 3 1/2 x 4 1/2	at	\$
	Old returned	Long 4 1/2 x 5 1/2	at	\$
		Buffalo	at	\$
6	Ft. in. G. I. Pipe	at	\$	
	Nipples	in. at	\$	
	Bushings	to in. at	\$	
1	Red'g Coup	to in. at	\$	
	Inc'g Coup	to in. at	\$	
	Union	in. at	\$	
	Meter	in. at	\$	
	Cu. Yds. Br. Stone	at	\$	
	Cu. Yds. Sand	at	\$	
	Bags Cement	at	\$	
	Paving Brick	{ Mack Red Asphalt }	at	\$
2	Hrs. Foreman	at	\$	
1	Hrs. Common Labor	at	\$	
	Hrs. Mason	at	\$	
	Hrs.	at	\$	
	Hrs.	at	\$	
g	Builders' Use of Water	at	\$	
	Truck	1.00	at	\$
		at	\$	
		at	\$	
		at	\$	
	Total	\$	9.70	

### Labor and Material Report June 11 1920

3/4 tap at 17 Horizon Ave  
17 Horizon Ave No  
Measurement

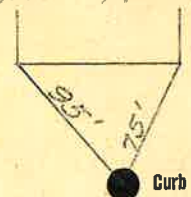

Curb Box

Main Elev. of Main at tap 4 1/2 ft  
Gate at ● Gate at ●

Curb Box