

Labor and Materials


...Copper } Connection.....	?	\$ 1.33
...Lead }		
...Curb { Cock } .....	2	\$ 1.58
...Curb { Valve } .....		
...Curb { T.S.&V. } .....		
...Service Box { Short 3 1/2 x 4 1/2 } .....		\$ 1.36
...Old returned { Long 4 1/2 x 5 1/2 } .....		
...Old returned { Buff. or Railway } .....		
31 Ft. .... in. { Copper } Pipe at .....		\$ 2.94
... { Galv. Iron } .....		
... { Cast Iron } .....		
...Nipples ..... in. at .....		\$ .05
...Bushings 1/2 to 3/4 in. at .....		\$ .05
...Red'g } Couplings..... 1/4 to ..... in. at .....		\$
...Inc'g }		
...Union..... in. at .....		\$
...Meter..... in. at .....		\$
...Lbs. Br. Stone at .....		\$
...Lbs. Sand at .....		\$
...Bags Cement at .....		\$
...Paving Brick { Mack } at .....		\$
...Paving Brick { Red } .....		
...Paving Brick { Asphalt } .....		
...Lead Joints at .....		\$
...Leadite Joints at .....		\$
3 Hrs. Foreman at .....		\$ 1.88
5 Hrs. Common Labor at Tapper .....		\$ 4.00
9 Hrs. Common Labor at .....		\$ 4.05
...Hrs. Mason at .....		\$
...Hrs. Masons Helper at .....		\$
...Hrs. Compressor at .....		\$
...Compensation Ins .....		\$ .31
...Trucking .....		\$ 1.00
...Builders Use of Water Patch .....		\$ 5.00
Total \$		73.50

33-35

Labor and Material Report June

16 19 33

18 Horcum Ave

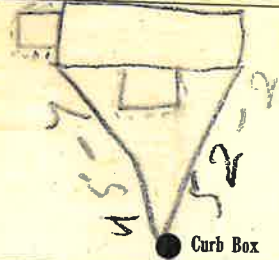

6 Main

Elev. of Main at tap 4 1/2

Gate at ●

● Gate at

● Curb Box

Old tap shut off

OK

W