

Labor and Materials


1	Copper } Connection		\$ 2.70
	Lead		
1	Curb } Cock Valve		\$ 2.39
		in.	
1	Service Box } Short 3/4 1/2		\$ 1.55
	Old returned } Long 1/2 x 5/8		
		Buff or Rdway	
10	Ft. 3/4 in. } Copper Galv. Iron } Pipe at		\$ 2.70
		Cast Iron	
	Nipples	in. at	\$
	Bushings	to in. at	\$
	Red'g } Couplings	to in. at	\$
	Inc'g		
	Union	in. at	\$
	Meter	in. at	\$
	Lbs. Br. Stone at		\$
	Lbs. Sand at		\$
	Bags Cement at		\$
	Paving Brick } Mack Red Asphalt	at	\$
	Lead Joints at		\$
	Leadite Joints at		\$
3	Hrs. Foreman at		\$ 1.88
1	Hrs. Common Labor at	50	\$.50
16	Hrs. Common Labor at	45	\$ 7.20
	Hrs. Mason at		\$
	Hrs. Mason's Helper at		\$
	Hrs. Compressor at		\$
	Compensation Ins		\$ 30
	Trucking		\$ 1.00
	Builders' Use of Water	Patch	\$ 5. —
Total \$			25.22

30-22

Labor and Material Report

4-16-1938

No 1 Horican ave

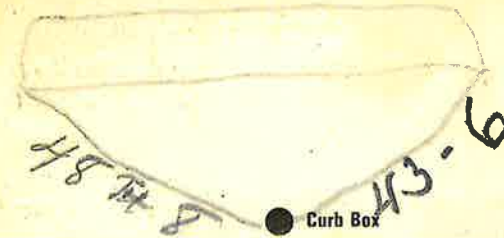

6 Main

Elev of Main at tap 5

Gate at ●

● Gate at

● Curb Box