

LABOR AND MATERIALS


1	Copper	Lead	Connection	3/4"		\$ 2.76
1	Curb	Cock Valve	T. S. & V.	3/4 in.		\$ 3.49
1	Service box	Old returned	Short 3/4 X 4 1/2			\$ 4.74
			Long 4 1/2 X 5 1/2			
			Buff or Rdway			\$ 4.74
30	Ft.	3/4 in.	Copper	Pipe at	38	\$ 11.40
			C.I.			
			C.I.			
	Nipples	in.	at			\$
	Bushings	to	in.	at		\$
	Red'g					
	Inc'g	Coupl'gs	to	in.	at	\$
	Union	in.	at			\$
	Meter	in.	at			\$
	Lead Joints	at				\$
	Compound Joints	at				\$
4	Hrs. Water Maint. Man	1 at	6.50			\$ 6.36
2	Hrs. Water Maint. Man	2 at	1.24			\$ 2.48
18	Hrs. Labor	at	1.13			\$ 20.34
	Hrs. Labor	at				\$
	Hrs. Compressor	at				\$
	Compensation Ins.	at \$ 3.406	per C			\$ 1.29
	Trucking					\$ 1.00
	Pav't Patch					\$ 16.20
Tap by LARCAU, 11-30-53						\$
	O'head					\$
						\$ 70.06

5386

St. 27
Pl. 02
Ave. No. 24

Name of Owner Woodbury

Labor and Mat'l. Report Nov. 30 1953

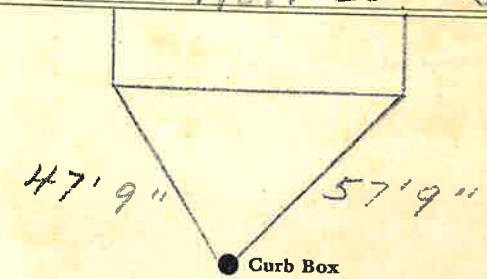

6" Main

Elev. of Main at tap 5'

Gate at ● ● Gate at

● Curb Box