


Labor and Materials

1	Copper	} Connection. <i>3/4</i>	\$ 1.25	
1	Lead				
1	Curb	{ Cock Valve T.S.&V. }	in <i>3/4</i>	\$ 1.70
1	Service Box				
	Old - returned	{ Short <i>3 1/2</i> x <i>4 1/2</i> Long <i>4 1/2</i> x <i>5 1/2</i> Buff. or Rdway }	\$ 1.45	
9	Ft. <i>3/4</i> in.	{ Copper Galv. Iron Cast Iron }	Pipe at <i>13.17</i>	\$ 1.22	
	Nipples in. at		\$	
	Bushings to in. at		\$	
	Red'g Inc'g	} Couplings..... to..... in. at.....		\$	
	Union	 in. at		\$
	Meter in. at		\$	
	Lbs. Br. Stone	at		\$	
	Lbs. Sand	at		\$	
	Bags Cement	at		\$	
	Paving Brick	{ Mack Red Asphalt }	at	\$	
	Lead Joints	at		\$	
	Leadite Joints	at		\$	
5	Hrs. Foreman	at	<i>6.12</i>	\$ 3.13	
10	Hrs. Common Labor	at	<i>5.00</i>	\$ 5.00	
A	Hrs. Common Labor	at	<i>4.50</i>	\$ 4.50	
	Hrs. Mason	at		\$	
	Hrs. Masons Helper	at		\$	
A	Hrs. Compressor	at	<i>1.50</i>	\$ 6.00	
	Compensation Ins		\$ <i>1.24</i>	
	Trucking		\$ <i>1.00</i>	
	Builders Use of Water <i>Patch</i>		\$ <i>2.50</i>	
Total				\$ 25.19	

1935-56

3/4" tap at 23

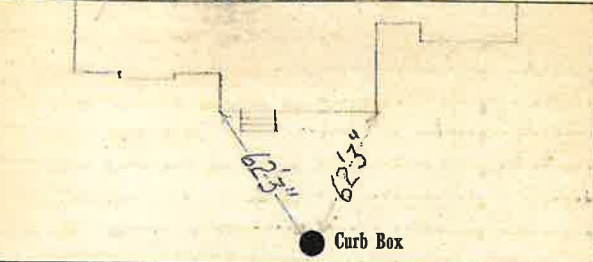

6 Main Elev. of Main at tap *54.1*

Gate at ● Gate at ●

● Curb Box

New House

J.H.