

**LABOR AND MATERIALS**


\_\_\_\_\_ Copper } Connection \_\_\_\_\_ \$  
 \_\_\_\_\_ Lead }  
 \_\_\_\_\_ Curb } Cock } \_\_\_\_\_ in. \$  
 \_\_\_\_\_ Valve }  
 \_\_\_\_\_ T.S. & V. }  
 \_\_\_\_\_ Service box { Short 3-1/2 x 4-1/2 } \_\_\_\_\_ \$  
 \_\_\_\_\_ Old returned { Long 4-1/2 x 5-1/2 }  
 \_\_\_\_\_ Ft. \_\_\_\_\_ in. { Copper } Pipe at \_\_\_\_\_ \$  
 \_\_\_\_\_ { G.I. }  
 \_\_\_\_\_ { C.I. }  
 \_\_\_\_\_ Nipples \_\_\_\_\_ in. at \_\_\_\_\_ \$  
 \_\_\_\_\_ Bushings \_\_\_\_\_ to \_\_\_\_\_ in. at \_\_\_\_\_ \$  
 \_\_\_\_\_ Red'g \_\_\_\_\_  
 \_\_\_\_\_ Inc'g \_\_\_\_\_  
 \_\_\_\_\_ Union \_\_\_\_\_ in. at \_\_\_\_\_ \$  
 \_\_\_\_\_ Meter \_\_\_\_\_ in. at \_\_\_\_\_ \$  
 \_\_\_\_\_ \$  
 \_\_\_\_\_ Compound Joints at \_\_\_\_\_ \$  
 \_\_\_\_\_ Maintenance Foreman \_\_\_\_\_ \$  
 \_\_\_\_\_ Hrs. Water Maint. Man - 1 at \_\_\_\_\_ \$  
 \_\_\_\_\_ Hrs. Water Maint. Man - 2 at \_\_\_\_\_ \$  
 \_\_\_\_\_ Hrs. Garage Foreman \_\_\_\_\_ at \_\_\_\_\_ \$  
 \_\_\_\_\_ Hrs. Labor \_\_\_\_\_ at \_\_\_\_\_ \$  
 \_\_\_\_\_ Hrs. Compressor at \_\_\_\_\_ \$  
 \_\_\_\_\_ \$  
 \_\_\_\_\_ Trucking \_\_\_\_\_ \$  
 \_\_\_\_\_ Pav't Patch \_\_\_\_\_ \$  
 \_\_\_\_\_ \$  
 \_\_\_\_\_ \$  
 \_\_\_\_\_ \$  
 \_\_\_\_\_ \$

HORICON

St. ~~Pl~~ Ave. No. 24

Name of Owner

TG III - MEASUREMENTS RECORDED  
 Labor and Mat'l. Report 19 09-05-2002

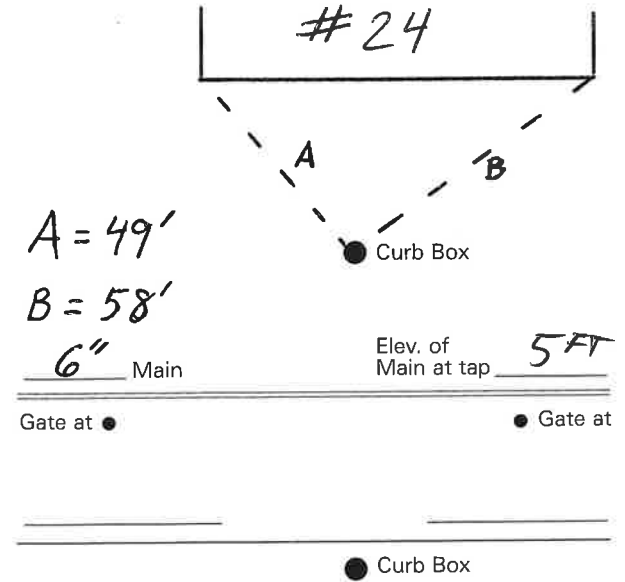

**20FT. TO THE MAIN LINE**  
**3/4" COPPER**  
**4FT. DEEP**  
**16" WATER MAIN**