

LABOR AND MATERIALS

| | | | | | |
|----|--------------------------|--|---------|----|-------|
| 1 | Copper Lead | Connection | 3/4" | \$ | 2.41 |
| 1 | Curb | Cock Valve T. S. & V. | 3/4 in. | \$ | 3.41 |
| 1 | Service box Old returned | Short 3 1/2 x 4 1/2 Long 4 1/2 x 5 1/2 Buff or Rdway | | \$ | 4.18 |
| 32 | Ft. 3/4 in. | Copper G.I. C.I. Pipe at | 40 | \$ | 12.80 |
| | Nipples | in. at | | \$ | |
| | Bushings | to in. at | | \$ | |
| | Red'g Inc'g | Coupl'gs to in. at | | \$ | |
| | Union | in. at | | \$ | |
| | Meter | in. at | | \$ | |
| | Lead Joints | at | | \$ | |
| | Compound Joints | at | | \$ | |
| | Maintenance Foreman | | | \$ | |
| | Hrs. Water Maint. Man-1 | at | | \$ | |
| 6 | Hrs. Water Maint. Man-2 | at | 1.24 | \$ | 7.44 |
| | Hrs. Garage Foreman | at | | \$ | |
| 6 | Hrs. Labor | at | 1.13 | \$ | 6.78 |
| | Hrs. Compressor | at | | \$ | |
| | Compensation Ins. | at \$38.61 per C. | | \$ | 55 |
| | Trucking | | | \$ | 1.50 |
| | Pav't Patch | | | \$ | 18.45 |
| | Tap made 4-21-54 | | | \$ | |
| | by Gifford & Wallace | | | \$ | |
| | O'head | | | \$ | |
| | | | | \$ | 57.52 |

19-54

St. Pl. Ave. No. 2

Horicon


Name of Owner

Derby

Labor and Mat'l. Report

April 21

1954

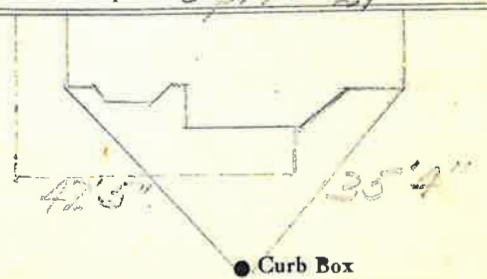

● Curb Box

6" Main

Elev. of Main at tap 5'

Gate at ●

● Gate at

● Curb Box

Old service has been disconnected at Main May 17-54

42' 5" 35' 4"