

LABOR AND MATERIALS

1	Copper	Connection	1"	\$
1	Lead	Cock		\$
1	Curb	Valve	3/4 in. <i>BRASS</i>	\$
		T.S. & V.		\$
1	Service box	Short 2 1/2	4' X 5'	\$
	Old returned	Long 4 1/2		\$
		Base or Redway		\$
8 1/2	Ft.	Copper		\$
		3/4 in.		\$
		Gal.		\$
		Pipe at		\$
	Nipples	in. at		\$
	Bushings	to in. at		\$
	Red'g			\$
	Inc'g	Coupl'gs. to in. at		\$
	Union	in. at		\$
	Meter	in. at		\$
1	Lead Joints at	BRASS 1/2" W 1 1/4" X 3/4"		\$
	Compound Joints at			\$
1	Maintenance Foreman	3/4" male adpt.		\$
	Hrs. Water Maint. Man-1	at		\$
	Hrs. Water Maint. Man-2	at		\$
	Hrs. Garage Foreman	at		\$
	Hrs. Labor	at		\$
	Hrs. Compressor at			\$
	Compensation Ins. at \$	per C		\$
	Trucking			\$
	Pav't Patch			\$
	TAP BY ST. JOHN & CO			\$
	MAY-21-1976			\$
	O'head			\$
				\$

HORIZON


St. No. 42

Name of Owner

Fred Vogel

Labor and Mat'l. Report

MAY 21 1976

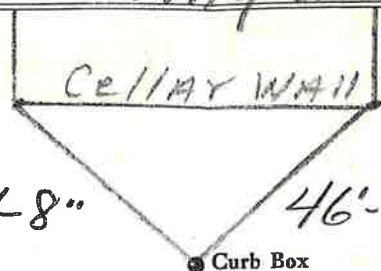

● Curb Box

6" Main

Elev. of Main at tap 5'

Gate at ●

● Gate at

● Curb Box