


# LABOR AND MATERIALS

Copper	}	Connection.....	.....	\$.....	
Lead					
Curb	}	Cock Valve T. S. & V. } ..... in. ....	.....	\$.....	
Service Box			}	Short 3½x4½ Long 4½x5½ Buff or Rdway } .....	\$.....
Old returned					
Ft.....	}	Copper Galv Iron Cast Iron } Pipe at.....	.....	\$.....	
in.					
Nipples.....		in. at .....		\$.....	
Bushings.....		to..... in. at .....		\$.....	
Red'g Inc'g } Couplings.....		to..... in. at .....		\$.....	
Union.....		in. at .....		\$.....	
Meter.....		in. at .....		\$.....	
Lead Joints at .....				\$.....	
Leadite Joints at .....				\$.....	
Hrs. Foreman at .....				\$.....	
Hrs. Chauffeur at .....				\$.....	
Hrs. Tapper at .....				\$.....	
Hrs. Labor at .....				\$.....	
Hrs. Labor at .....				\$.....	
Hrs. Compressor at .....				\$.....	
Compensation Ins. ....				\$.....	
Trucking .....				\$.....	
Builders Use of Water .....				\$.....	
.....				\$.....	
.....				\$.....	
-St:  
 -Pl:  
*Horicon*  
 Ave. No. *46*

Name of Owner

Labor and Mat'l. Report **AUG 23 1939** 19

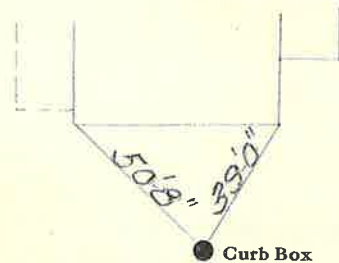

	Elev. of
..... Main	Main at tap.....
Gate at ●	● Gate at
● Curb Box	