

LABOR AND MATERIALS

1	Copper Lead	{ Connection	-----	\$ 1.23
1	Curb	{ Cock Valve T. S. & V. } $\frac{3}{4}$ in.	-----	\$ 1.68
1	Service Box	{ Short $3\frac{1}{2} \times 4\frac{1}{2}$ Long $4\frac{1}{2} \times 5\frac{1}{2}$ Buff. or Rdway }	-----	\$ 1.54
	Old returned			
7	Ft. $\frac{3}{4}$ in.	{ Copper Galv Iron Cast Iron } Pipe at	-----	\$ 1.19
	Nipples	in. at	-----	\$
	Bushings	to in. at	-----	\$
	Red'g Inc'g	{ Couplings to in. at	-----	\$
	Union	in. at	-----	\$
	Meter	in. at	-----	\$
	Lead Joints	at	-----	\$
	Leadite Joints	at	-----	\$
	Hrs. Foreman	at	-----	\$
7	Hrs. Chauffeur	at $12\frac{1}{2}$	-----	\$ 1.25
6	Hrs. Tapper	at	-----	\$ 3.75
4	Hrs. Labor	at $K$	-----	\$ 1.80
	Hrs. Labor	at	-----	\$
	Hrs. Compressor	at	-----	\$
	Compensation Ins.		-----	\$ .21
	Trucking		-----	\$ 1.00
	Builders Use of Water		-----	\$
	Tap by <i>Heard</i>		-----	\$
	Patch by <i>Seward Dept.</i>		-----	\$ 2.50
			-----	\$
			-----	\$
			-----	\$ 16.15

12 -- 1939

-St-

-Pt-


Horicon

Ave. No. 48

Name of Owner

Bucks

Labor and Mat'l. Report May 15 1939

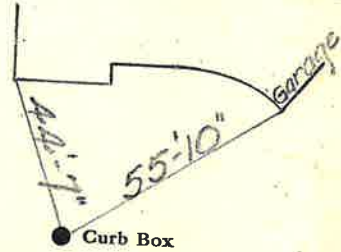

6" Main

Elev. of Main at tap 5'

Gate at ●

● Gate at

● Curb Box

New House