

LABOR AND MATERIALS

Copper	}	Connection.....		\$	
Lead					
Curb	{	Cock Valve T. S. & V. in.	\$	
Service Box			Short 3"x4 1/2"	}	\$
Old returned	Long 4"x5 1/2"				
	Buff or Rdway				
Ft.	{	Pipe at.....	Copper	\$	
..... in.			Galv Iron		
			Cast Iron		
Nipples in. at		\$		
Bushings to..... in. at		\$		
Red'g Inc'g	}	Couplings..... to..... in. at		\$	
Union		 in. at	\$	
Meter in. at		\$		
Lead Joints at			\$		
Leadite Joints at			\$		
Hrs. Foreman at			\$		
Hrs. Chauffeur at			\$		
Hrs. Tapper at			\$		
Hrs. Labor at			\$		
Hrs. Labor at			\$		
Hrs. Compressor at			\$		
Compensation Ins.			\$		
Trucking			\$		
Builders Use of Water			\$		
			\$		
			\$		
			\$		
			\$		

St.

Pl.


Horicon

Ave. No. *49*

Name of Owner

Labor and Mat'l. Report **AUG 23 1939**

19

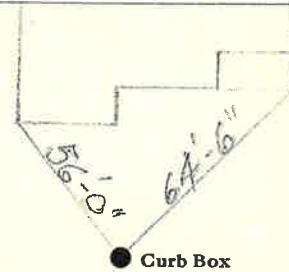

Main

Elev. of

Main at tap

Gate at ●

● Gate at

● Curb Box