


**Labor and Materials**

1	Copper } Connection	3/4	\$	
	Lead } Connection	3/4	\$	
1	Curb } Cock	3/4	\$	
	Valve } T. S. & V.	3/4	\$	
	in.		\$	
1	Service Box } Short 3" x 4"		\$	
	Old returned } Long 4" x 5"		\$	
		Buff. or Rdway	\$	
15	Ft. in.	Copper } Pipe at.	\$	
		Galv. Iron }	\$	
		Cast Iron }	\$	
	Nipples	in. at.	\$	
	Bushings	to in. at.	\$	
	Red'g } Couplings	to in. at.	\$	
	Inc'g }		\$	
	Union	in. at.	\$	
	Meter	in. at.	\$	
	Lbs. Br. Stone	at.	\$	
	Lbs. Sand	at.	\$	
	Bags Cement	at.	\$	
	Paving Brick } Mack	} at.	\$	
				Red
				Asphalt
	Lead Joints	at.	\$	
	Leadite Joints	at.	\$	
2	Hrs. Foreman	at.	\$	
12	Hrs. Common Labor	at.	\$	
	Hrs. Common Labor	at.	\$	
	Hrs. Mason	at.	\$	
	Hrs. Mason's Helper	at.	\$	
	Hrs. Compressor	at.	\$	
	Compensation Ins.		\$	
	Trucking		\$	
	Builders' Use of Water		\$	
	<b>Total</b>	\$		

3/4 Tap Horicon Ext

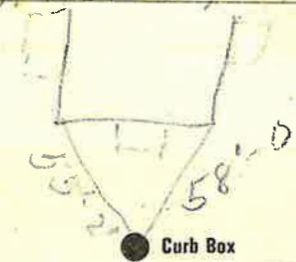

6" Main Elev. of Main at tap 4 1/2

Gate at ● Gate at ●

● Curb Box

3/4 tap Horicon Ext

55' 2" 58' 0"