


Labor and Materials

1	Copper } Connection.....	\$ 3 20
1	Curb { Cock Valve } in.....	\$ 1 00
	{ T-S. & V. }	
1	Service Box { Short 3 1/2 x 4 1/2 }.....	\$ 1 30
	Old returned { Long 4 1/2 x 5 1/2 } { Buff. or Rdway }	
30	Ft. 3/4 in. { Copper } Pipe at.....	\$ 6 60
	{ Galv. Iron }	
	{ Cast Iron }	
	Nipples..... in. at.....	\$
	Bushings..... to..... in. at.....	\$
1	Red 1/2 in. } Couplings..... to..... in. at.....	\$ 1 40
	Union..... in. at.....	\$
	Meter..... in. at.....	\$
	Lbs. Br. Stone at.....	\$
	Lbs. Sand at.....	\$
	Bags Cement at.....	\$
	Paving Brick { Mack } at.....	\$
	{ Red }	
	{ Asphalt }	
	Lead Joints at.....	\$
	Leadite Joints at.....	\$
	Hrs. Foreman at.....	\$
11	Hrs. Common Labor at.. 50.....	\$ 5 50
	Hrs. Common Labor at.....	\$
	Hrs. Mason at.....	\$
	Hrs. Mason's Helper at.....	\$
	Hrs. Compressor at.....	\$
	Compensation Ins.....	\$ 1 60
	Trucking.....	\$ 1 00
	Builders' Use of Water.....	\$
Total		\$ 18 91

Labor and Material Report

July 10 19 26

Horicon Ave

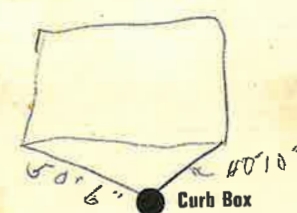

● Curb Box

6" Main

Elev. of Main at tap 5

Gate at ●

● Gate at

● Curb Box

Horicon Ave

50' 6"

40' 10"