

LABOR AND MATERIALS

1 Copper Lead	} Connection <u>3/4</u>	\$
1 Curb		} Cock Valve T.S. & V. <u>3/4</u> in.
1 Service box Old returned	{ Short 3 1/2 x 4 1/2 Long 4 1/2 x 5 1/2 Buff or Rdway }	
9 Ft. <u>3/4</u> in.		{ Copper G.I. C.I. } Pipe at
Nipples	in. at	\$
Bushings	to in. at	\$
Red'g Inc'g	} Coupl'gs to in. at	\$
Union		in. at
Meter	in. at	\$
Lead Joints	at	\$
Compound Joints	at	\$
Maintenance Foreman		\$
Hrs. Water Maint. Man-1	at	\$
Hrs. Water Maint. Man-2	at	\$
Hrs. Garage Foreman	at	\$
Hrs. Labor	at	\$
Hrs. Compressor	at	\$
Compensation Ins. at \$	per C	\$
Trucking		\$
Pav't Patch		\$
<u>Tap June 2, 1978</u>		\$
O'head		\$
		\$

Horicon


~~St.~~
~~Pl.~~
Ave. No. 5

Name of Owner

Catherine O'Conner

Labor and Mat'l. Report

June 2 1978

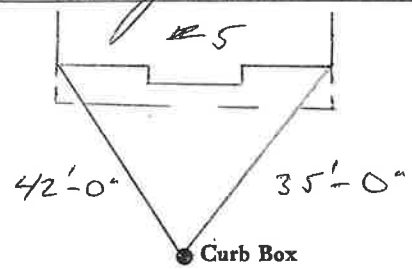

6" Main

Elev. of Main at tap 5'

Gate at ●

● Gate at

● Curb Box


LABOR AND MATERIALS

_____ Copper } Connection _____ \$ _____	
_____ Lead } _____	
_____ Curb } Cock } _____ in. _____ \$ _____	
_____ } Valve } _____	
_____ } T.S. & V. } _____	
_____ Service box { Short 3-1/2 x 4-1/2 } _____ \$ _____	
_____ Old returned { Long 4-1/2 x 5-1/2 } _____	
_____ Ft. _____ in. { Copper } Pipe at _____ \$ _____	
_____ } G.I. }	
_____ } C.I. }	
_____ Nipples _____ in. at _____ \$ _____	
_____ Bushings _____ to _____ in. at _____ \$ _____	
_____ Red'g _____	
_____ Inc'g _____	
_____ Union _____ in. at _____ \$ _____	
_____ Meter _____ in. at _____ \$ _____	
_____ \$ _____	
_____ Compound Joints at _____ \$ _____	
_____ Maintenance Foreman _____ \$ _____	
_____ Hrs. Water Maint. Man - 1 at _____ \$ _____	
_____ Hrs. Water Maint. Man - 2 at _____ \$ _____	
_____ Hrs. Garage Foreman _____ at _____ \$ _____	
_____ Hrs. Labor _____ at _____ \$ _____	
_____ Hrs. Compressor at _____ \$ _____	
_____ \$ _____	
_____ Trucking _____ \$ _____	
_____ Pav't Patch _____ \$ _____	
_____ \$ _____	
_____ \$ _____	
St. Horicon
 Pl. _____
 Ave. No. 5

 Name of Owner

Labor and Mat'l. Report # 2015 11/23/15

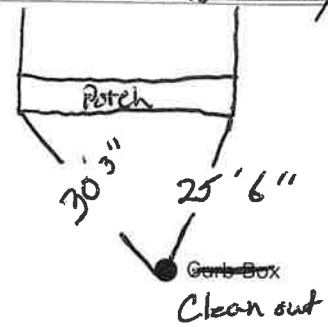

_____ Main Elev. of Main at tap _____

Gate at ● Gate at ●

● Curb Box