


**Labor and Materials**

1	Copper	Connection	3	\$ 2.60
1	Curb	Cock Valve T. S. & V. } in.	3	\$ 2.30
1	Service Box	Short 3/4x4 1/2		\$ 1.40
	Old returned	Long 1 1/2x3 1/2 Built or Rdwy		
31	Ft.	Copper Pipe at	3	\$ 8.22
	Nipples	in. at		\$
1	Bushings	1/2 to 3/4 in. at		\$ 1.0
	Red'g Inc'g } Couplings	to	in. at	\$
	Union	in. at		\$
	Meter	in. at		\$
	Lbs. Br. Stone	at		\$
	Lbs. Sand	at		\$
	Bags Cement	'at		\$
	Paving Brick	Mack Red Asphalt } at		\$
	Lead Joints	at		\$
	Leadite Joints	at		\$
2	Hrs. Foreman	at		\$ 1.75
16	Hrs. Common Labor	at		\$ 6.50
	Hrs. Common Labor	at		\$
	Hrs. Mason	at		\$
	Hrs. Mason's Helper	at		\$
	Hrs. Compressor	at		\$
	Compensation Ins			\$ .24
	Trucking			\$ 1.00
	Builders' Use of Water	Patch		\$ 5.00
Total				\$ 28.58

29-34

Labor and Material Report April 27 1929

8 Horcau Ave

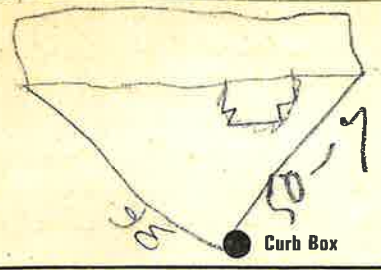

6 Main Eley of Main at tap 1/2  
 Gate at ● Gate at ●

● Curb Box  
 old tap disconnected  
 2 holes in str to  
 be repaired  
 stop shows  
 off when on