

LABOR AND MATERIALS


Copper	} Connection				
Lead				\$	
Curb	{ Cock	} in.		\$	
	Valve				
	T. S. & V.				
Service box	{ Short 3½ x 4½				
Old returned					
				\$	
15 Ft.	3/4 in.	{ Copper	} Pipe at	\$	
		G.I.			
		C.I.			
Nipples	in.	at		\$	
Bushings	to	in.	at	\$	
Red'g	} Coupl'gs	to	in.	at	\$
Inc'g					
Union	in.	at		\$	
Meter	in.	at		\$	
				\$	
Compound Joints	at			\$	
Maintenance Foreman				\$	
Hrs. Water Maint. Man—1	at			\$	
Hrs. Water Maint. Man—2	at			\$	
Hrs. Garage Foreman	at			\$	
Hrs. Labor	at			\$	
Hrs. Compressor	at			\$	
				\$	
Trucking				\$	
Pav't Patch				\$	
				\$	
				\$	
				\$	
				\$	

St.
 Pl.
 Ave. No. 10

Howey

Name of Owner _____

Labor and Mat'l. Report 1951

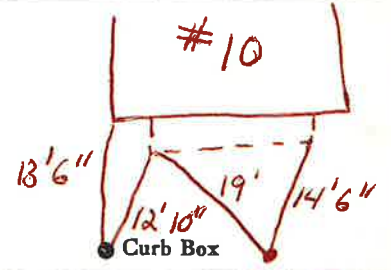

1 1/4" Blow off

4" Main Elev. of Main at tap 4 1/2'

Gate at ● ● Gate at

● Curb Box


LABOR AND MATERIALS

_____	Copper } Connection _____	\$ _____
_____	Lead } _____	\$ _____
_____	Curb } Cock _____ in.	\$ _____
_____	Valve } _____	\$ _____
_____	T.S. & V. } _____	\$ _____
_____	Service box { Short 3-1/2 x 4-1/2 }	\$ _____
_____	Old returned { Long 4-1/2 x 5-1/2 }	\$ _____
_____	Ft. _____ in. { Copper } Pipe at _____	\$ _____
_____	G.I. } _____	\$ _____
_____	C.I. } _____	\$ _____
_____	Nipples _____ in. at _____	\$ _____
_____	Bushings _____ to _____ in. at _____	\$ _____
_____	Red'g _____	\$ _____
_____	Inc'g _____	\$ _____
_____	Union _____ in. at _____	\$ _____
_____	Meter _____ in. at _____	\$ _____
_____	_____	\$ _____
_____	Compound Joints at _____	\$ _____
_____	Maintenance Foreman _____	\$ _____
_____	Hrs. Water Maint. Man - 1 at _____	\$ _____
_____	Hrs. Water Maint. Man - 2 at _____	\$ _____
_____	Hrs. Garage Foreman _____ at _____	\$ _____
_____	Hrs. Labor _____ at _____	\$ _____
_____	Hrs. Compressor at _____	\$ _____
_____	_____	\$ _____
_____	Trucking _____	\$ _____
_____	Pav't Patch _____	\$ _____
_____	_____	\$ _____
_____	_____	\$ _____
St. _____
 Pl. _____
 Ave. No. _____

Name of Owner
10 Hovey ST

Labor and Mat'l. Report 19 _____

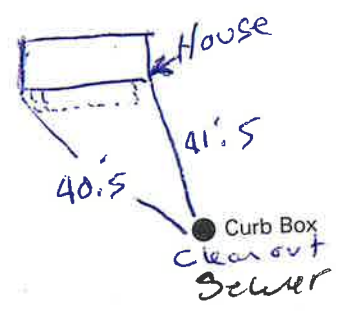

_____ Main
 Elev. of Main at tap _____

Gate at ● _____ ● Gate at _____

_____ ● Curb Box