
Labor and Materials 96 Copper Connection ... Cock .Curb Short 31/2 x4 1/2 ·/···Service Box Old returned But 50 Copper Pipe at 1.5 1.0. .Ft......in. Cost Iron .....Nipples .....in. at ..... ..... .....Bushings .....to .....in. at......\$..... Red's Couplings.....to.....in.at....\$.... .....Union.....in, at ..... .....Meter.....in. at ..... .....Lbs. Br. Stone at ..... .....Lbs. Sand at ..... .....Bags Cement at ..... Mack .....Paving Brick Red at ..... Asphalt .....Lead Joints at ..... Leadite Joints at ..... 3.1.3. S ... Hrs. -Foreman at 10 Hrs. Common Labor at ..... ......Hrs. Common Labor at ..... ......Hrs. Mason at ..... .....Hrs. Masons Helper at .....\$. .....Hrs. Compressor at ..... .....Compensation Ins ..... .....Trucking ..... .....Builders Use of Water Vale Total \$. 9.00

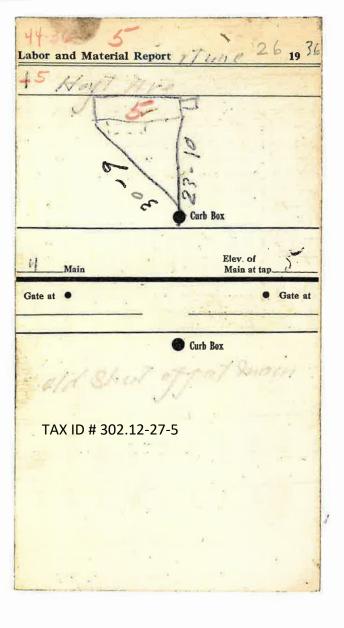

Old shut off at main