

LABOR AND MATERIALS

1	Copper } Connection	3 1/4"		\$ 1.80
	Lead }			
1	Curb { Cock Valve } F. S. & V. }	3 1/4 in.		\$ 1.96
	Service Box Old returned	{ Short 3 1/2 x 4 1/2 Long 4 1/2 x 5 1/2 Buffer Rdway }	Same Box	\$ —
9	Ft. 3/4 in. { Copper Galv Iron Cast Iron }	Pipe at 19		\$ 1.71
1	Nipples 3/4 in. at	Galv iron 2 ft long		\$ 1.00
	Bushings to	in. at		\$ —
1	Red'g Inc'g } Couplings	1/2 to 3/4 in. at		\$.25
	Union	in. at		\$ —
	Meter	in. at		\$ —
	Lead Joints at			\$ —
	Leadite Joints at			\$ —
7	Hrs. Foreman at			\$ 4.81
7	Hrs. Chauffeur at			\$ 4.20
7	Hrs. Labor at	60		\$ 4.20
	Hrs. Labor at			\$ —
	Hrs. Compressor at			\$ —
	Compensation Ins.	2.669		\$.24
	Trucking			\$ 1.00
	Builders Use of Water			\$ 4.68
	Taps by <i>Wassilichio</i>			\$ —
				\$ —
				\$ —
				\$ —
				\$ —
				\$ 20.75


21-44

St 15 AB
Pl. Ave. No. H

Hoyt

Name of Owner
Bankowiski

Labor and Mat'l. Report Sept 11 1944

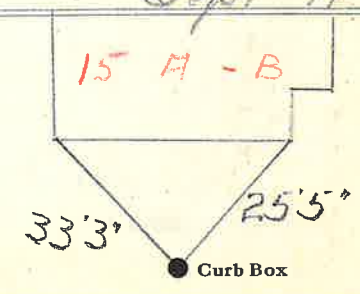

4 Main Elev. of Main at tap 5

Gate at ● Gate at ●

TAX ID # 302.12-27-20

● Curb Box