

LABOR AND MATERIALS


... 1. Copper	} Connection	3/4	\$ 2.87		
... 1. Lead						
... 1. Curb	} Valve	3/4	in.	\$ 3.62		
					T. S. & V.	
... 1. Service box	} Short 3 1/2 X 4 1/2	}	\$		
... 1. Old returned					Long 4 1/2 X 5 1/2	} Same
					Buff or Rdway	
25 Ft. 3/4 in.	} Copper	}	Pipe at 32	\$ 8.00		
					G.I.	
					C.I.	
..... Nipples in. at	\$		
..... Bushings to in. at	\$		
..... Red'g	} Coupl'gs to in. at	\$		
..... Inc'g						
..... Union in. at	\$		
..... Meter in. at	\$		
..... Lead Joints	at	\$		
..... Compound Joints	at	\$		
..... Hrs. Water Maint. Man-1	at	\$		
5 Hrs. Water Maint. Man-2	at	1.02	5.10	\$		
22 Hrs. Labor	at	.91	20.02	\$		
..... Hrs. Labor	at	\$		
..... Hrs. Compressor	at	\$		
..... Compensation Ins.	at \$ 2.18 per C	55	\$		
..... Trucking	2.50	\$		
..... Pav't Patch	10.25	\$		
Top by [unclear]	\$		
..... O'head	\$		
			\$ 52.41			

80

St. _____
 Pl. _____
 Ave. No. 16

Name of Owner
 Hopt
 Boston

Labor and Mat'l. Report July 27 1941

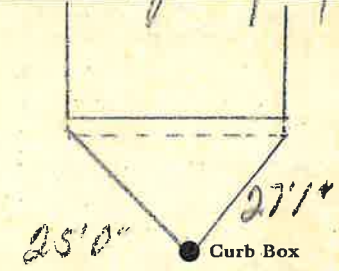

1 Main Elev. of Main at tap 4
 Gate at ● Gate at ●

● Curb Box