

LABOR AND MATERIALS


1	Copper Lead	Connection	3/4"	\$
1	Curb	Cock Valve	3/4" in.	\$
1	Service box	Short 3 1/2 x 4 1/2	} ?	\$
	Old returned	Long 4 1/2 x 5 1/2		
		Buff or Rdway		
8	Ft.	3/4 in. Copper Pipe at		\$
		G.I.		\$
		C.I.		\$
	Nipples	in. at		\$
	Bushings	to in. at		\$
	Red'g Inc'g	Coupl'gs to in. at		\$
	Union	in. at		\$
	Meter	in. at		\$
	Lead Joints	at		\$
	Compound Joints	at		\$
	Maintenance Foreman			\$
	Hrs. Water Maint. Man—1	at		\$
	Hrs. Water Maint. Man—2	at		\$
	Hrs. Garage Foreman	at		\$
	Hrs. Labor—	at		\$
	Hrs. Compressor at			\$
	Compensation Ins. at \$	per C		\$
	Trucking			\$
	Pay't Patch			\$
	Tap by Gifford & Co.			\$
		4-16-57		\$
	O'head			\$

St.
 Pl.
 Ave. No. 19

Hout

Name of Owner
 Tupper

Labor and Mat'l. Report
 Apr. 15-16 1957

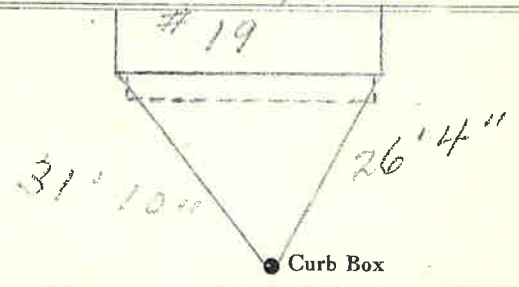

4" Main
 Elev. of Main at tap 5'
 Gate at • Gate at

• Curb Box
 Apr. 15 & 16