

LABOR AND MATERIALS


1	Copper	Connection	3/4"	\$	3.08
1	Lead				
1	Curb	Cock Valve	3/4" in.	\$	3.89
		T.S. & V.			
1	Service box	Short 3 1/2 x 4 1/2		\$	4.32
	Old returned	Long 4 1/2 x 5 1/2			
		Buff or Rdway			
27	Ft. 3/4 in.	Copper Pipe at	45	\$	12.15
		G.I.			
		C.I.			
	Nipples	in. at		\$	
	Bushings	to in. at		\$	
	Red'g				
	Inc'g	Coupl'gs to in. at		\$	
	Union	in. at		\$	
	Meter	in. at		\$	
	Lead Joints at			\$	
	Compound Joints at			\$	
	Maintenance Foreman			\$	
	Hrs. Water Maint. Man-1 at			\$	
14 1/2	Hrs. Water Maint. Man-2 at	16.13		\$	23.39
	Hrs. Garage Foreman	at		\$	
22	Hrs. Labor	at	1.30	\$	29.60
	Hrs. Compressor at			\$	
	Compensation Ins. at \$	5.86 per C.		\$	2.96
	Trucking			\$	1.50
	Pav't Patch			\$	14.40
	Tap by Gissard & Co.			\$	
		10-10-56		\$	
	O'head			\$	
				\$	
				\$	94.29

79.89

Hoyt St. No. 6
 Ave. No. 6

Name of Owner
 Peters

Labor and Mat'l. Report Oct. 10 1956

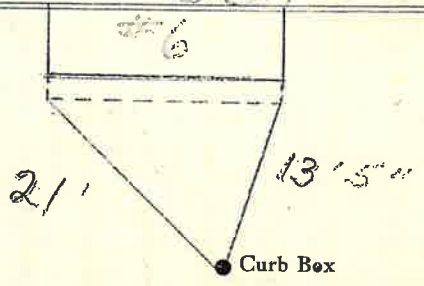

4" Main Elev. of Main at tap 5'

Gate at ● ● Gate at

● Curb Box