

LABOR AND MATERIALS


Copper	} Connection			\$						
Lead										
Curb	} Cock Valve T. S. & V.	} in.			\$					
Service box	} Short 3 1/2 x 4 1/2 Long 4 1/2 x 5 1/2 Buff or Rdway				\$					
Old returned										
20 Ft. 3/4 in.	} Copper S.I. C.I.	} Pipe at			\$					
Nipples			in. at		\$					
Bushings			to in. at		\$					
Red'g Inc'g	} Coupl'gs	} to in. at			\$					
Union			in. at		\$					
Meter	in. at			\$						
Lead Joints at				\$						
Compound Joints at				\$						
Maintenance Foreman				\$						
Hrs. Water Maint. Man-1	at			\$						
Hrs. Water Maint. Man-2	at			\$						
Hrs. Garage Foreman	at			\$						
Hrs. Labor	at			\$						
Hrs. Compressor at				\$						
Compensation Ins. at \$	per C			\$						
Trucking				\$						
Pav't Patch				\$						
				\$						
				\$						
				\$						
O'head				\$						

St. Pl. Ave. No. 7

Name of Owner East

New Measurements

Labor and Mat'l. Report JULY 17 1984

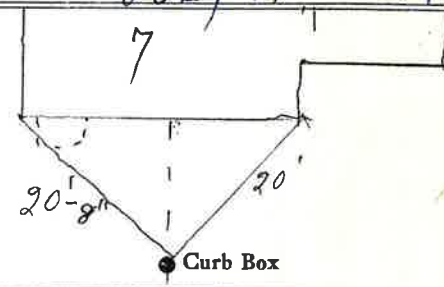

Main

Elev. of Main at tap

Gate at • 3 H Copper • Gate at

20' to main

• Curb Box

*Added 9 feet to original
feet of Copper*