



LABOR AND MATERIALS

_____	Copper } Connection _____	\$ _____
_____	Lead } _____	\$ _____
_____	Curb } Cock } _____ in. _____	\$ _____
_____	_____ } Valve } _____	\$ _____
_____	_____ } T.S. & V. } _____	\$ _____
_____	Service box { Short 3-1/2 x 4-1/2 } _____	\$ _____
_____	Old returned { Long 4-1/2 x 5-1/2 } _____	\$ _____
_____	Ft. _____ in. { Copper } Pipe at _____	\$ _____
_____	_____ } G.I. } _____	\$ _____
_____	_____ } C.I. } _____	\$ _____
_____	Nipples _____ in. at _____	\$ _____
_____	Bushings _____ to _____ in. at _____	\$ _____
_____	Red'g _____	\$ _____
_____	Inc'g _____	\$ _____
_____	Union _____ in. at _____	\$ _____
_____	Meter _____ in. at _____	\$ _____
_____	_____	\$ _____
_____	Compound Joints at _____	\$ _____
_____	Maintenance Foreman _____	\$ _____
_____	Hrs. Water Maint. Man - 1 at _____	\$ _____
_____	Hrs. Water Maint. Man - 2 at _____	\$ _____
_____	Hrs. Garage Foreman _____ at _____	\$ _____
_____	Hrs. Labor _____ at _____	\$ _____
_____	Hrs. Compressor at _____	\$ _____
_____	_____	\$ _____
_____	Trucking _____	\$ _____
_____	Pav't Patch _____	\$ _____
_____	_____	\$ _____
_____	_____	\$ _____
St. _____
Pl. _____
Ave. No. 51
Name of Owner Hussow

Labor and Mat'l. Report 19 _____

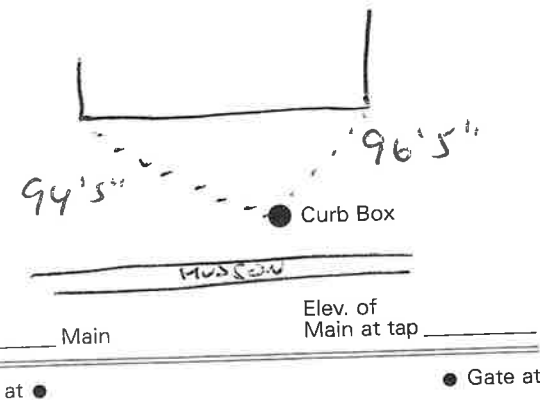

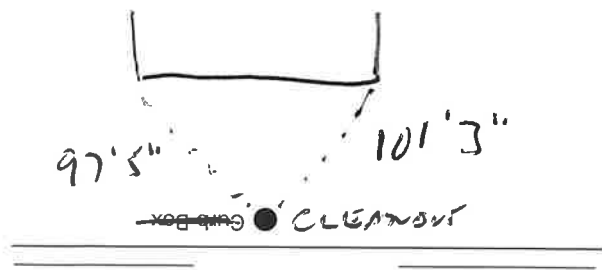

● Gate at ● Gate at
 Main Elev. of Main at tap

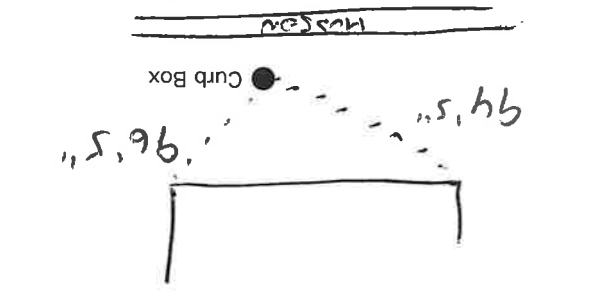

Labor and Mat'l. Report 19

Name of Owner

Hudson
 St. Pl. Ave. No. 51