

LABOR AND MATERIALS


Copper } Connection _____ \$ _____
 Lead }
 Curb } Cock Valve } _____ in. \$ _____
 T.S. & V. }
 Service box { Short 3-1/2 x 4-1/2 } _____ \$ _____
 Old returned { Long 4-1/2 x 5-1/2 }
 Ft. _____ in. { Copper } Pipe at _____ \$ _____
 { G.I. }
 { C.I. }
 Nipples _____ in. at _____ \$ _____
 Bushings _____ to _____ in. at _____ \$ _____
 Red'g _____
 Inc'g _____
 Union _____ in. at _____ \$ _____
 Meter _____ in. at _____ \$ _____
 _____ \$ _____
 Compound Joints at _____ \$ _____
 Maintenance Foreman _____ \$ _____
 Hrs. Water Maint. Man - 1 at _____ \$ _____
 Hrs. Water Maint. Man - 2 at _____ \$ _____
 Hrs. Garage Foreman _____ at _____ \$ _____
 Hrs. Labor _____ at _____ \$ _____
 Hrs. Compressor at _____ \$ _____
 _____ \$ _____
 Trucking _____ \$ _____
 Pav't Patch _____ \$ _____
 _____ \$ _____
 _____ \$ _____
Hudson

St. Ave. No. 52

Name of Owner

Labor and Mat'l. Report 19

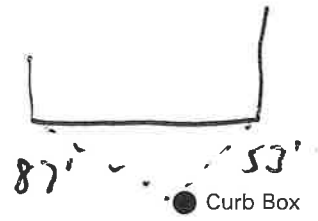

Main

Elev. of Main at tap

Gate at ●

● Gate at

● Curb Box

Labor and Materials


Lead	Copper } Connection.....	3/4	\$ 96
Lead	Curb { Cock Valve }	3/4	\$ 1.33
	{ P.S.&V. }	1/4	
	Service Box { Short 3 1/2 x 4 1/2 }		\$ 1.35
	Old returned { Long 4 1/2 x 5 1/2 }		
	{ Buff. or Rdway }		
2.5 Ft.	in. { Copper } Pipe at	3/4	\$ 3.75
	{ Galv. Iron }		
	{ Cast Iron }		
	Nipples	in. at	\$
	Bushings	to	in. at \$
	Red'g } Couplings.....	to	in. at \$
	Inc'g }		
	Union.....	in. at	\$
	Meter.....	in. at	\$
	Lbs. Br. Stone at		\$
	Lbs. Sand at		\$
	Bags Cement at		\$
	Paving Brick { Mack } at		\$
	{ Red }		
	{ Asphalt }		
	Lead Joints at		\$
	Leadite Joints at		\$
2	Hrs. Foreman at	6 1/2	\$ 1.88
16	Hrs. Common Labor at		\$ 7.20
	Hrs. Common Labor at		\$
	Hrs. Mason at		\$
	Hrs. Masons Helper at		\$
	Hrs. Compressor at		\$
	Compensation Ins		\$ 28
	Trucking		\$ 1.00
	Builders Use of Water <i>no patch</i>		\$
Total			\$ 17.75

Labor and Material Report

19

72/36 52

3857 Hudson Ave

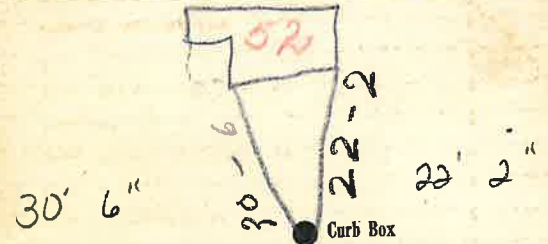

6 Main

Elev. of Main at tap 5

Gate at ●

● Gate at

● Curb Box

old shut off at main