


Labor and Materials

Copper	} Connection.....	3	96
Lead			
Curb	} Cock Valve T.S.&V. }	in	1.33
Service Box	} Short 3 1/2 x 4 1/2 }		1.35
Old returned			
2.6 Ft.	} Copper Galv. Iron Cast Iron }	in	15
			3.90
Nipples	in. at		
Bushings	to in. at		
Red'g Inc'g	} Couplings.....to.....in.at		
Union	in. at		
Meter	in. at		
Lbs. Br. Stone	at		
Lbs. Sand	at		
Bags Cement	at		
Paving Brick	} Mack Red Asphalt }	at	
Lead Joints		at	
Leadite Joints	at		
3 Hrs.	Foreman at	6.75	1.87
11 Hrs.	Common Labor at	4.50	4.95
Hrs. Common Labor	at		
Hrs. Mason	at		
Hrs. Masons Helper	at		
Hrs. Compressor	at		
Compensation Ins			21
Trucking			1.00
Builders Use of Water	no patch		
	D.P.		
Total			\$ 15.58

40 Hudson Ave

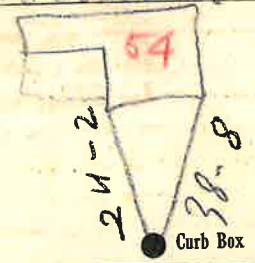

6 Main Elev. of Main at tap 5.2

Gate at ● Gate at ●

● Curb Box

old shut off

MA