

LABOR AND MATERIALS

1	Copper Lead	Connection	$\frac{3}{4}$	\$	1.59	
1	Curb	Clock Valve T. S. & V.		\$	2.74	
1	Service box Old returned	Short $3\frac{1}{2} \times 4\frac{1}{2}$ Long $4\frac{1}{2} \times 5\frac{1}{2}$ Buff or Rdway		\$	1.82	
11	Ft.	Copper Galv. Iron Cast Iron	Pipe at $\frac{3}{4}$ in.	\$	2.09	
	Nipples	in. at		\$		
	Bushings	to in. at		\$		
	Red'g Inc'g	Couplings to in. at		\$		
	Union	in. at		\$		
	Meter	in. at		\$		
	Lead Joints at			\$		
	Compound Joints at			\$		
	Hrs. Foreman at			\$		
4	Hrs. Chauffeur at			\$	2.75	
	Hrs. Tapper at			\$		
4	Hrs. Labor at	60		\$	2.40	
	Hrs. Labor at			\$		
	Hrs. Compressor at			\$		
	Compensation Ins.			\$	16	
	Trucking			\$	1-	
	Builders Use of Water.			\$	5.00	
	Total by Watson's Dr. & Gen.				\$	
					\$	
					\$	
					\$	20.55

16-115 ✓

St. 55"
Pl.
Ave. No. 15

Name of Owner
Geo W Robillard

Labor and Mat'l. Report July 11 1945

55'
20'5" 21'2"
● Curb Box

6 Main Elev. of Main at tap 5

Gate at ● Gate at ●
Shutoff at curb 3-17-1942


● Curb Box
6-55"
Hydrant

Welding
Snyder

LSM-5C-6-1-45

LSM-SC-6-1-45
Gordon's
Welding

Hydrant

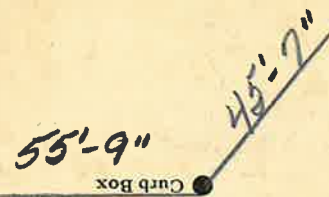

Gate at ● Gate at ●
Shutoff at curb 3-17-1972

Main Elev. of Main at tap 5



Labor and Mat'l. Report July 11 1945

Geo W Robillard

Name of Owner

St. Pl. Ave. No. Hudson

55

16-45