


# LABOR AND MATERIALS

_____	Copper } Connection _____	\$ _____
_____	Lead } _____	\$ _____
_____	Curb } Cock _____	\$ _____
_____	Valve } _____ in. _____	\$ _____
_____	T.S. & V. } _____	\$ _____
_____	Service box { Short 3-1/2 x 4-1/2 } _____	\$ _____
_____	Old returned { Long 4-1/2 x 5-1/2 } _____	\$ _____
_____	Ft. _____ in. { Copper } Pipe at _____	\$ _____
_____	{ G.I. } _____	\$ _____
_____	{ C.I. } _____	\$ _____
_____	Nipples _____ in. at _____	\$ _____
_____	Bushings _____ to _____ in. at _____	\$ _____
_____	Red'g _____	\$ _____
_____	Inc'g _____	\$ _____
_____	Union _____ in. at _____	\$ _____
_____	Meter _____ in. at _____	\$ _____
_____	_____	\$ _____
_____	Compound Joints at _____	\$ _____
_____	Maintenance Foreman _____	\$ _____
_____	Hrs. Water Maint. Man - 1 at _____	\$ _____
_____	Hrs. Water Maint. Man - 2 at _____	\$ _____
_____	Hrs. Garage Foreman _____ at _____	\$ _____
_____	Hrs. Labor _____ at _____	\$ _____
_____	Hrs. Compressor at _____	\$ _____
_____	_____	\$ _____
_____	Trucking _____	\$ _____
_____	Pav't Patch _____	\$ _____
_____	_____	\$ _____
_____	_____	\$ _____
_____	_____	\$ _____
_____	_____	\$ _____

Mission St. Pl. Ave. No. 56


Name of Owner \_\_\_\_\_

Labor and Mat'l. Report 19 \_\_\_\_\_

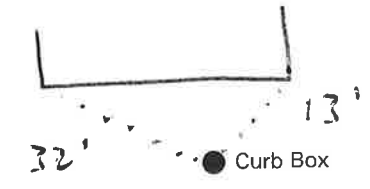

\_\_\_\_\_ Main Elev. of Main at tap \_\_\_\_\_

Gate at ● Gate at ●

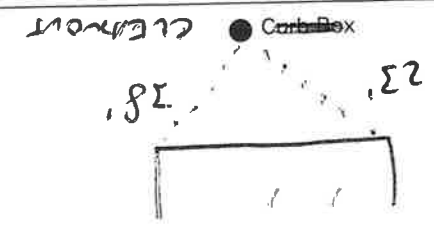

LABOR AND MATERIALS

1 Copper } Connection 3/4" \$  
 Lead }  
 1 Curb } Cock } 3/4 in. OYLSEAL \$  
 Valve }  
 T. S. & V. }  
 1 Service box { Short 3 1/2 x 4 1/2 }  
 Old returned { Long 4 1/2 x 5 1/2 }  
 Buffer Rdway } \$  
 26 Ft. 3/4" in. { Copper } Pipe at \$  
 { G.I. }  
 { G.I. }  
 Nipples in. at \$  
 Bushings to in. at \$  
 Red'g }  
 Inc'g } Coupl'gs to in. at \$  
 Union in. at \$  
 Meter in. at \$  
 Lead Joints at \$  
 Compound Joints at \$  
 Maintenance Foreman \$  
 Hrs. Water Maint. Man—1 at \$  
 Hrs. Water Maint. Man—2 at \$  
 Hrs. Garage Foreman at \$  
 Hrs. Labor— at \$  
 Hrs. Compressor at \$  
 Compensation Ins. at \$ per C \$  
 Trucking \$  
 Pav't Patch \$  
Tap By Beecher & Co \$  
Feb-3-1976 \$  
 O'head \$  
 \$

St. No. 56

Hudson Ave. No. 56

Name of Owner Mike + Bucks

Labor and Mat'l. Report Feb 3 1976

36'      21'-6"  
Curb Box

6" Main      Elev. of Main at tap 5

Gate at •      • Gate at

• Curb Box

LSM-SC-6-1-67