



# LABOR AND MATERIALS

Copper } Connection \_\_\_\_\_ \$ \_\_\_\_\_  
 Lead }  
 Curb } Cock } \_\_\_\_\_ in. \_\_\_\_\_ \$ \_\_\_\_\_  
 Valve }  
 T.S. & V. }  
 Service box { Short 3-1/2 x 4-1/2 } \_\_\_\_\_ \$ \_\_\_\_\_  
 Old returned { Long 4-1/2 x 5-1/2 }  
 Ft. \_\_\_\_\_ in. { Copper } Pipe at \_\_\_\_\_ \$ \_\_\_\_\_  
 { G.I. }  
 { C.I. }  
 Nipples \_\_\_\_\_ in. at \_\_\_\_\_ \$ \_\_\_\_\_  
 Bushings \_\_\_\_\_ to \_\_\_\_\_ in. at \_\_\_\_\_ \$ \_\_\_\_\_  
 Red'g \_\_\_\_\_  
 Inc'g \_\_\_\_\_  
 Union \_\_\_\_\_ in. at \_\_\_\_\_ \$ \_\_\_\_\_  
 Meter \_\_\_\_\_ in. at \_\_\_\_\_ \$ \_\_\_\_\_  
 \_\_\_\_\_ \$ \_\_\_\_\_  
 Compound Joints at \_\_\_\_\_ \$ \_\_\_\_\_  
 Maintenance Foreman \_\_\_\_\_ \$ \_\_\_\_\_  
 Hrs. Water Maint. Man - 1 at \_\_\_\_\_ \$ \_\_\_\_\_  
 Hrs. Water Maint. Man - 2 at \_\_\_\_\_ \$ \_\_\_\_\_  
 Hrs. Garage Foreman \_\_\_\_\_ at \_\_\_\_\_ \$ \_\_\_\_\_  
 Hrs. Labor \_\_\_\_\_ at \_\_\_\_\_ \$ \_\_\_\_\_  
 Hrs. Compressor at \_\_\_\_\_ \$ \_\_\_\_\_  
 \_\_\_\_\_ \$ \_\_\_\_\_  
 Trucking \_\_\_\_\_ \$ \_\_\_\_\_  
 Pav't Patch \_\_\_\_\_ \$ \_\_\_\_\_  
 \_\_\_\_\_ \$ \_\_\_\_\_  
 \_\_\_\_\_ \$ \_\_\_\_\_  
Husson St. \_\_\_\_\_  
 Pl. \_\_\_\_\_ Ave. No. 58  
 Name of Owner \_\_\_\_\_  
 \_\_\_\_\_  
 Labor and Mat'l. Report 19 \_\_\_\_\_

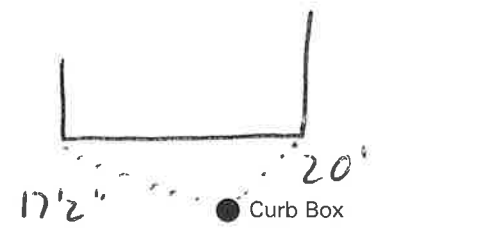

\_\_\_\_\_ Main      Elev. of Main at tap \_\_\_\_\_  
 Gate at ●      ● Gate at

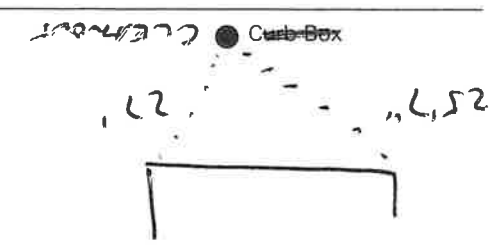

LABOR AND MATERIALS

1 Copper } Connection 3/4" \$  
 Lead }  
 1 Curb } Cock } 3/4 in. ORISEAL \$  
 } Valve }  
 } T.S. & V. }  
 1 Service box { Short 3 1/2 x 4 1/2 }  
 Old returned { Long 4 1/2 x 5 1/2 } \$  
 Buil-or-Rdway }  
 26 Ft. 3/4 in. { Copper } Pipe at. \$  
 } G.I. }  
 } C.I. }  
 Nipples in. at \$  
 Bushings to in. at \$  
 Red'g }  
 Inc'g } Coupl'gs to in. at \$  
 Union in. at \$  
 Meter in. at \$  
 Lead Joints at \$  
 Compound Joints at \$  
 Maintenance Foreman \$  
 Hrs. Water Maint. Man-1 at \$  
 Hrs. Water Maint. Man-2 at \$  
 Hrs. Garage Foreman at \$  
 Hrs. Labor at \$  
 Hrs. Compressor at \$  
 Compensation Ins. at \$ per C \$  
 Trucking \$  
 Pav't Patch \$  
 TAP MADE BY LAROCHE & CO \$  
 O'head Dec 4-1971 \$  
 \$  
 \$


HUDSON Ave. No. 58

Name of Owner

ALAN LACROSS

Labor and Mat'l. Report

Dec 4 1971

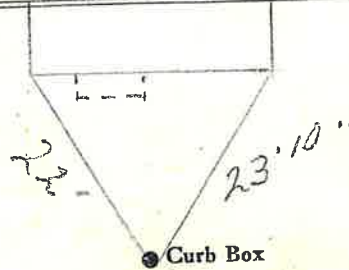

● Curb Box

6" Main

Elev. of Main at tap 4"

Gate at ●

● Gate at

● Curb Box