

LABOR AND MATERIALS

| | | | | | | |
|----|-------------------------|------------------|---------------------|--------|---------|----------|
| 1 | Copper | Lead | Connection | 3/4 | | \$ 2.87 |
| 1 | Curb | Cock Valve | T. S. & V. | 3/4 | in. | \$ 3.62 |
| 1 | Service box | Old returned | Short 3 1/2 X 4 1/2 | | | \$ 4.68 |
| | | | Long 4 1/2 X 5 1/2 | | | |
| | | | Buff or Rdway | | | \$ 8.96 |
| 25 | Ft. | 3/4 in. | Copper | 32 | Pipe at | |
| | | | G.I. | | | |
| | | | C.I. | | | |
| | Nipples | in. | at | | | \$ |
| | Bushings | to | in. at | | | \$ |
| | Inc'g | Coupl'gs | to | in. at | | \$ |
| | Union | in. | at | | | \$ |
| | Meter | in. | at | | | \$ |
| | Lead Joints | at | | | | \$ |
| | Compound Joints | at | | | | \$ |
| | Hrs. Water Maint. Man-1 | at | | | | \$ |
| 5 | Hrs. Water Maint. Man-2 | at | 1.02 | | | \$ 5.10 |
| 21 | Hrs. Labor- | at | 91 | | | \$ 19.11 |
| | Hrs. Labor- | at | | | | \$ |
| 2 | Hrs. Compressor | at | 1.20 | | | \$ 2.40 |
| | Compensation Ins. | at \$ 2.18 per C | | | | \$.52 |
| | Trucking | | | | | \$ 2.00 |
| | Pav't Patch | | | | | \$ 10.25 |
| | Tap by <i>M. J. ...</i> | | | | | \$ |
| | O'head | | | | | \$ |
| | | | | | | \$ 59.51 |


99

Hudson

St. _____
Pl. _____
Ave. No. 60

Name of Owner
Robillard

Labor and Mat'l. Report Sept 9 1949

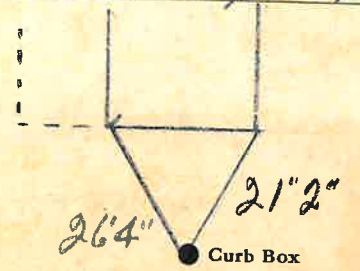

6 Main Elev. of Main at tap 6

Gate at ● ● Gate at

● Curb Box

LABOR AND MATERIALS


_____ Copper } Connection _____ \$ _____
 _____ Lead }
 _____ Curb } Cock } _____ in. _____ \$ _____
 _____ Valve }
 _____ T.S. & V. }
 _____ Service box { Short 3-1/2 x 4-1/2 } _____ \$ _____
 _____ Old returned { Long 4-1/2 x 5-1/2 }
 _____ Ft. _____ in. { Copper } Pipe at _____ \$ _____
 _____ { G.I. }
 _____ { C.I. }
 _____ Nipples _____ in. at _____ \$ _____
 _____ Bushings _____ to _____ in. at _____ \$ _____
 _____ Red'g _____
 _____ Inc'g _____
 _____ Union _____ in. at _____ \$ _____
 _____ Meter _____ in. at _____ \$ _____
 _____ \$ _____
 _____ Compound Joints at _____ \$ _____
 _____ Maintenance Foreman _____ \$ _____
 _____ Hrs. Water Maint. Man - 1 at _____ \$ _____
 _____ Hrs. Water Maint. Man - 2 at _____ \$ _____
 _____ Hrs. Garage Foreman _____ at _____ \$ _____
 _____ Hrs. Labor _____ at _____ \$ _____
 _____ Hrs. Compressor at _____ \$ _____
 _____ \$ _____
 _____ Trucking _____ \$ _____
 _____ Pav't Patch _____ \$ _____
 _____ \$ _____
 _____ \$ _____
Hudson

St. _____
 Pl. _____
 Ave. No. 60

Name of Owner _____

Labor and Mat'l. Report 19

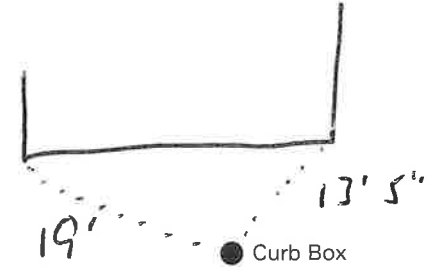


_____ Main


Elev. of Main at tap _____

Gate at ●


● Gate at

_____ Curb Box

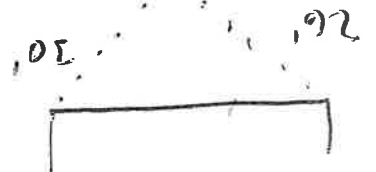

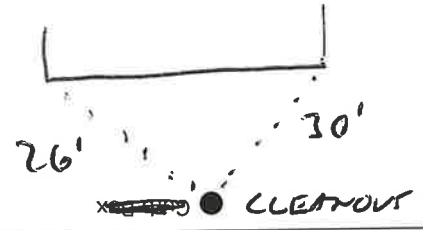

Gate at ●
 Main at tap
 Elev. of

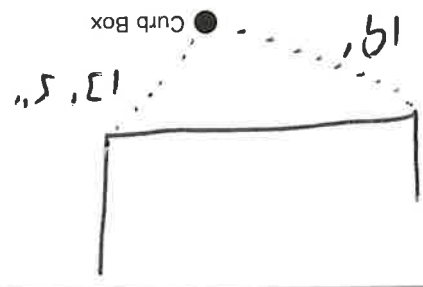

Labor and Mat'l. Report 19

Name of Owner
 Hudson
 St. Pl. Ave. No. 60