


Gate at ● Gate at ●
 Main at tap Main
 Elev. of

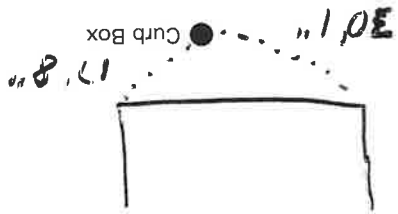

Labor and Mat'l. Report 19

Name of Owner

St. Ave. No. 62
 Pl. Ave. No. 62


MASON

MASON


St. Ave. No. 62
 Pl. Ave. No. 62

Name of Owner

Labor and Mat'l. Report 19

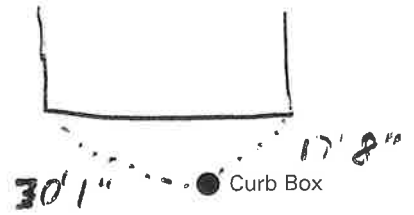

Gate at ● Gate at ●
 Main Elev. of Main at tap

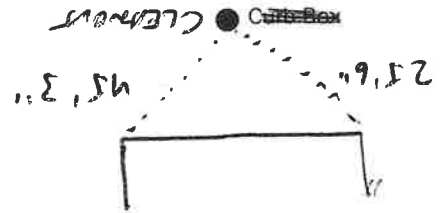


Labor and Materials

1	Copper	Connection	3	\$	96
1	Curb	Cock Valve	1	\$	133
1	Service Box	Short 2 1/2 x 4 1/2	1	\$	1.25
	Old returned	Long 4 1/2 x 5 1/2			
26	Ft. 3/4 in.	Copper Galv. Iron Pipe at	15	\$	3.90
		Cast Iron			
	Nipples	in. at		\$	
	Bushings	to in. at		\$	
	Red'g Inc'g	Couplings to in. at		\$	
	Union	in. at		\$	
	Meter	in. at		\$	
	Lbs. Br. Stone	at		\$	
	Lbs. Sand	at		\$	
	Bags Cement	at		\$	
	Paving Brick	Mack Red Asphalt at		\$	
	Lead Joints	at		\$	
	Leadite Joints	at		\$	
4	Hrs. Foreman	at	6 1/2	\$	2.50
6	Hrs. Common Labor	at	50	\$	3.00
12	Hrs. Common Labor	at	45	\$	6.75
	Hrs. Mason	at		\$	
	Hrs. Masons Helper	at		\$	
	Hrs. Compressor	at		\$	
	Compensation Ins			\$	34
	Trucking			\$	1
	Builders Use of Water	no patch		\$	
				Total \$	19.78

51-30 62-ABCD Labor and Material Report July 15 1936

50-56 62 Hudson Ave

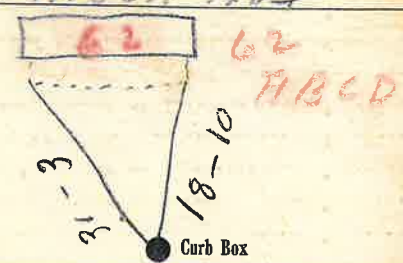

6 Main Elev. of Main at tap 5
 Gate at ● Gate at ●

● Curb Box
 old shut off at main
 MB
 MUST USE SMALL WRENCH
 - CURB STOP NEAR SIGN