

LABOR AND MATERIALS

1	Copper Lead	Connection	3/4"		\$ 2.76
1	Curb	Cock Valve	3/4" in.		\$ 2.49
		T. S. & V.			
1	Service box	Short	3 1/2 X 4 1/2		\$ 4.74
	Old returned	Long	4 1/2 X 5 1/2		
		Buff or Rdway			
28	Ft.	Copper	Pipe at	38	\$ 10.64
		G. I.			
		C. I.			
	Nipples	in. at			\$
	Bushings	to in. at			\$
	Red'g				\$
	Inc'g	Coupl'gs to in. at			\$
	Union	in. at			\$
	Meter	in. at			\$
	Lead Joints	at			\$
	Compound Joints	at			\$
	Hrs. Water Maint. Man—1	at			\$
11	Hrs. Water Maint. Man—2	at	1.24		\$ 13.64
24	Hrs. Labor—	at	1.13		\$ 27.12
	Hrs. Labor—	at			\$
	Hrs. Compressor	at			\$
	Compensation Ins. at \$	4.406 per C.			\$ 1.80
	Trucking				\$ 1.00
	Pav't Patch				\$ 18.90
	Tap July 2-53 by				\$
	Gibbard & George				\$
	O'head				\$
					\$ 84.09

65.19

40.76


53 53

St.
Pl.
Ave. No. 70

Hudson

Name of Owner
Fred La Point

Labor and Mat'l. Report July 2 1953

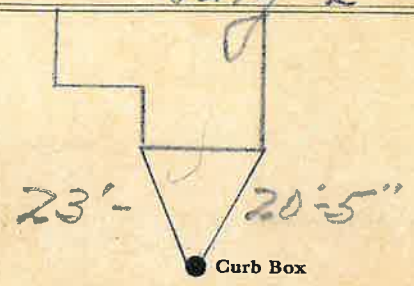

6" Main Elev. of Main at tap 5 1/2'

Gate at ● ● Gate at

● Curb Box