

LABOR AND MATERIALS

1. Copper Connection $\frac{3}{4}$	\$ 2.94
Lead	
1. Curb Cock Valve $\frac{3}{4}$ in. T. S. & V.	\$ 3.71
1. Service box Old returned	
Short $3\frac{1}{2} \times 4\frac{1}{2}$	
Long $4\frac{1}{2} \times 5\frac{1}{2}$	
Buff or Rdway	\$ 5.90
26 Ft. $\frac{3}{4}$ in. Copper Pipe at 30	\$ 7.80
G. I.	
C. I.	
..... Nipples..... in. at.....	\$.....
..... Bushings..... to..... in. at.....	\$.....
..... Red'g / Inc'g Coupl'gs..... to..... in. at.....	\$.....
..... Union..... in. at.....	\$.....
..... Meter..... in. at.....	\$.....
..... Lead Joints at.....	\$.....
..... Compound Joints at.....	\$.....
1 Hrs. Water Maint. Man—1 at 1.12	\$ 1.12
11 Hrs. Water Maint. Man—2 at 1.02	\$ 11.22
21 Hrs. Labor—... at 91	\$ 19.11
..... Hrs. Labor—... at.....	\$.....
2 Hrs. Compressor at.....	\$.....
..... Compensation Ins. at \$..... per C.....	\$ 69
..... Trucking.....	\$ 1.00
..... Pav't Patch.....	\$ 10.70
Tap & Measure	
.....	\$.....
.....	\$.....
..... O'head.....	\$.....
	\$ 64.19

123


St. Hudson
Pl. Ave. No. 74

Name of Owner

Hart

Labor and Mat'l. Report

Sept 17 1948

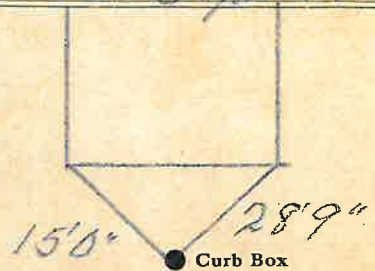


6 Main


Elev. of Main at tap 6

Gate at ●

● Gate at

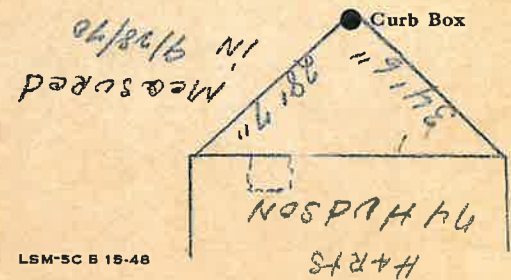


LSM-5C B 15-48

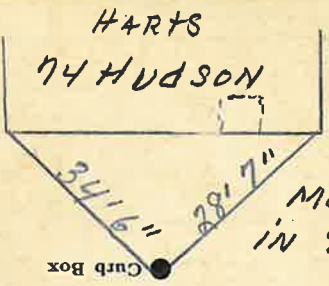

Measured
in 6/26/6

Gate at ● Gate at ●
 Elev. of Main at tap 6 Main 6

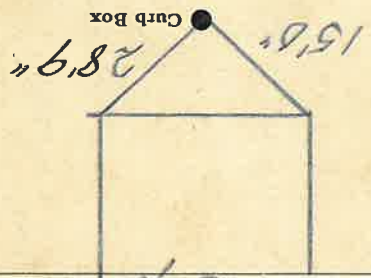

Labor and Mat'l. Report
Sept 17 1948

Name of Owner
Hart

Hillsboro
 St. Pl. Ave. No. 74