


Labor and Materials

Copper } Connection.....	3	\$ 3.20
Lead }	5	
Curb } Cock Valve }	1	\$ 1.00
} T.S. & V. }	1	
Service Box } Short 3/4x1 1/2 }		\$ 1.40
Old returned } Long 4 1/2x5 1/2 }		
} Buff. or Rdway }		
25 Ft. } in. } Copper } Pipe at.....	3	\$ 5.50
} } Galv. Iron }	1	
} } Cast Iron }		
Nipples..... in. at.....		\$
Bushings..... to..... in. at.....		\$
Red'g } Couplings..... to..... in. at.....		\$
Inc'g }		\$
Union..... in. at.....		\$
Meter..... in. at.....		\$
Lbs. Br. Stone at.....		\$
Lbs. Sand at.....		\$
Bags Cement at.....		\$
Paving Brick } Mack } at.....		\$
} Red }		
} Asphalt }		
Lead Joints at.....		\$
Leadite Joints at.....		\$
2 Hrs. Foreman at.....		\$ 1.20
6 Hrs. Common Labor at.....		\$ 2.44
Hrs. Common Labor at.....		\$
Hrs. Mason at.....		\$
Hrs. Mason's Helper at.....		\$
Hrs. Compressor at.....		\$
Compensation Ins.....		\$.10
Trucking.....		\$ 1.00
Builders' Use of Water.....		\$
Total \$ 15.89		

28-90 **78** Aug. 4 1928

68 1/2 Hudson Ave.

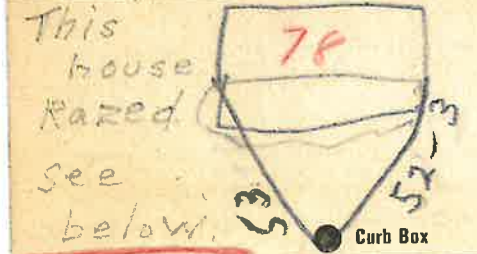

6 Main Elev of Main at tap
Gate at ● Gate at ●

