

**Labor and Materials**


Copper } Connection.....	3	\$ 2.60
Lead }.....	47	\$ 2.30
Curb } Cock Valve }..... in.....	1	\$ 1.50
T.S. & V. }.....	1	\$ 6.36
Service Box } Short 3x4 1/2 }.....	3	\$ 6.36
Old returned } Long 4 1/2 x 5 1/2 }.....	4	\$
2 1/4 Ft. }..... in. } Copper } Pipe at.....	3	\$
..... in. } Galv. Iron }.....	4	\$
..... in. } Cast Iron }.....		\$
Nipples..... in. at.....		\$
Bushings..... to..... in. at.....		\$
Red'g } Couplings..... to..... in. at.....		\$
Inc'g }.....		\$
Union..... in. at.....		\$
Meter..... in. at.....		\$
Lbs. Br. Stone at.....		\$
Lbs. Sand at.....		\$
Bags Cement at.....		\$
Paving Brick } Mack } at.....		\$
} Red }.....		\$
} Asphalt }.....		\$
Lead Joints at.....		\$
Leadite Joints at.....		\$
Hrs. Foreman at.....		\$ 1.88
3 Hrs. Common Labor at.....		\$ 1.22
3 1/2 Hrs. Common Labor at.....		\$
Hrs. Mason at.....		\$
Hrs. Mason's Helper at.....		\$
Hrs. Compressor at.....		\$
Compensation Ins.....		\$ .43
Trucking.....		\$ 1.00
Builders' Use of Water Patch.....		\$ 5.00
<b>Total \$</b>		<b>35.29</b>

29-54

26413 May 14

**Labor and Material Report** 19 22

18 Hudson Ave.

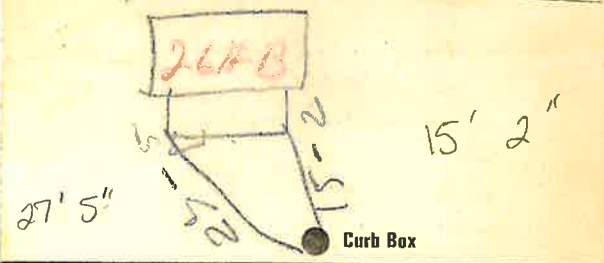

6 Main Eley of Main at tap 2 1/2

Gate at ● Gate at ●

● Curb Box

Old tap to be dug up  
Shutoff at curb  
Dec-27-1972