


Hudson

St.
Pl.
Ave. No.

80

Name of Owner


Labor and Mat'l. Report 19

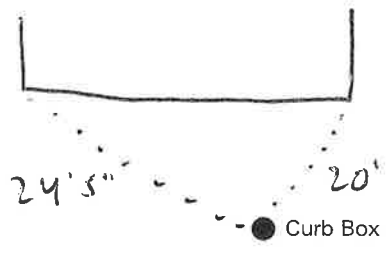

Main Elev. of Main at tap

Gate at Gate at

Curb Box CLEANOUT

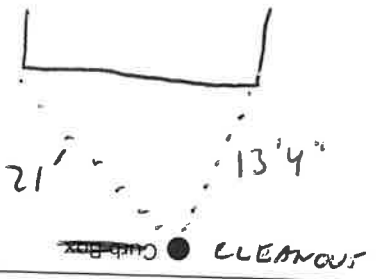

Main Elev. of Main at tap Gate at Gate at



Labor and Mat'l. Report 19

Name of Owner

Hudson
St.
Pl.
Ave. No.
80

LABOR AND MATERIALS


1	Copper	} Connection	$\frac{3}{4}$		\$ 2.80	
	Lead					
1	Curb	{ Clock Valve T.S. & V. }	in.		\$ 3.60	
	Service box					
1	Old returned	{ Short $3\frac{1}{2}$ X $4\frac{1}{2}$ Long $4\frac{1}{2}$ X $5\frac{1}{2}$ Buff or Rdway }	}		\$ 5.80	
26	Ft. $\frac{3}{4}$ in.			{ Copper Galv. Iron Cast Iron }	Pipe at $3\frac{5}{8}$	\$ 9.10
	Nipples in. at					\$
	Bushings	to in. at		\$		
	Red'g Inc'g	} Couplings	to in. at		\$	
	Union			in. at		\$
	Meter	in. at		\$		
	Lead Joints	at		\$		
	Compound Joints	at		\$		
	Hrs. Foreman	at		\$		
1	Hrs. Chauffeur	at	91	\$ 91		
4	Hrs. Tapper	at	91	\$ 364		
1.8	Hrs. Labor	at	80	\$ 144.0		
	Hrs. Labor	at		\$		
1	Hrs. Compressor	at	$87\frac{1}{2}$	\$ 87		
	Compensation Ins.			\$ 42		
	Trucking			\$ 1		
	Builders Use of Water			\$ 5.60		
	<i>Tally Magnolia</i>			\$		
				\$		
				\$		
				\$ 48.15		

141-17

Hudson St. Pl. Ave. No. 80

Name of Owner *LePoint*

Labor and Mat'l. Report Oct 14 1947

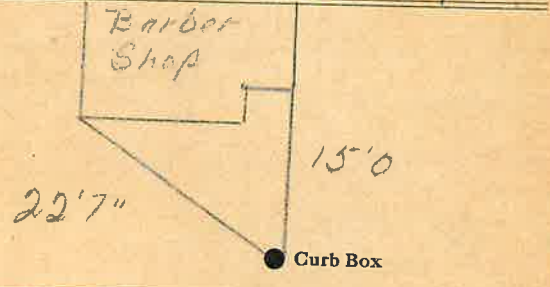

6 Main Elev. of Main at tap 6

Gate at ● Gate at ●

● Curb Box

Labor and Materials

Copper	Connection			\$	
Lead					
Curb	Cock Valve	in			
	T. S. & V.				
Service Box	Short 3 1/2 x 4 1/2	}			
Old returned	Long 4 1/2 x 5 1/2	}			
	Buff. or Rdway				
Ft. in.	Copper	} Pipe at			
	Galv Iron				
	Cast Iron				
Nipples		in. at			
Bushings		to in. at			
Red'g	Conplings	to in. at			
Inc'g					
Union		in. at			
Meter		in. at			
Lead Joints at					\$
Leadite Joints at					\$
Hrs. Foreman at					\$
Hrs. Chauffeur at					\$
Hrs. Tapper at					\$
Hrs. Labor at					\$
Hrs. Labor at					\$
Hrs. Compressor at					\$
Compensation Ins.					\$
Trucking					\$
Builders Use of Water					\$
					\$
					\$
8070

St. _____
Pl. _____
Ave. No. 7A

Name of Owner
D. J. Weller

Labor and Mat'l. Report A-29 1922

8070

● Curb Box

	Elev. of Main at tap.....
..... Main	
Gate at ●	● Gate at

10/10/22

● Curb Box

24' 3" 23' 1"

80 AB