


Labor and Materials

|  |       |          |
|--|-------|----------|
| Copper } Connection.....                       | 3     | \$ 1.50  |
| Lead } .....                                   | 3     | \$ 1.70  |
| Curb { Cock } .....                            | 3     | \$ 1.70  |
| { Valve } .....                                |       |          |
| { T.S.C.V. } .....                             |       |          |
| Service Box { Short 3 1/2 x 4 1/2 } .....      |       | \$ 1.44  |
| Old returned { Long 4 1/2 x 5 1/2 } .....      |       |          |
| { Buff. or Railway } .....                     |       |          |
| 30 Ft. } .. in. { Copper } Pipe at .....       |       | \$ 5.70  |
| { Galv. Iron } .....                           |       |          |
| { Cast Iron } .....                            |       |          |
| Nipples .....                                  |       | \$ ..... |
| Bushings .....                                 |       | \$ ..... |
| Red'g } Couplings.....to.....in.at.....        |       | \$ ..... |
| Inc'g } .....                                  |       |          |
| Union.....in. at .....                         |       | \$ ..... |
| Meter.....in. at .....                         |       | \$ ..... |
| Lbs. Br. Stone at .....                        |       | \$ ..... |
| Lbs. Sand at .....                             |       | \$ ..... |
| Bags Cement at .....                           |       | \$ ..... |
| Paving Brick { Mack } at .....                 |       | \$ ..... |
| { Red } .....                                  |       |          |
| { Asphalt } .....                              |       |          |
| Lead Joints at .....                           |       | \$ ..... |
| Leadite Joints at .....                        |       | \$ ..... |
| 5 Hrs. Foreman at .....                        | 62.12 | \$ 3.13  |
| 24 Hrs. Common Labor at .....                  | 45    | \$ 1.68  |
| Hrs. Common Labor at .....                     |       | \$ ..... |
| Hrs. Mason at .....                            |       | \$ ..... |
| Hrs. Masons Helper at .....                    |       | \$ ..... |
| Hrs. Compressor at .....                       |       | \$ ..... |
| Compensation Ins .....                         |       | \$ 0.50  |
| Trucking .....                                 |       | \$ 2.50  |
| Builders Use of Water <i>Power Patch</i> ..... |       | \$ 5.00  |
| Total \$                                       |       | 31.77    |

40 34 89 H-13  
 Labor and Material Report Aug 17 1934

74 Hudson Ave

Shot off curb  
 2.8.1934

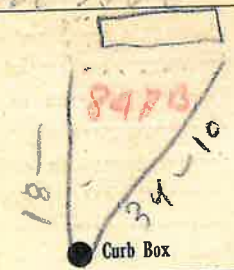

6 Main Elev. of Main at tap 5 1/2  
 Gate at ● Gate at ●

● Curb Box  
*old shot off at main*  
 House to be Razed  
 NYP Pole  
 Old curb Box - S.W.  
 Catch Basin  
 East