


LABOR AND MATERIALS

Copper	}	Connection	-----	\$		
Lead			-----	\$		
Curb	}	Cock Valve T. S. & V.	-----	in. -----	\$	
Service Box			}	Short 3 1/2 x 4 1/2 Long 4 1/2 x 5 1/2 Buff. or Rdway	-----	\$
Old returned					-----	\$
Ft. -----	in. -----	}	Pipe at	-----	\$	
				Copper		
				Galv Iron Cast Iron		
Nipples	-----	in. at	-----	\$		
Bushings	-----	to -----	in. at	-----	\$	
Red'g Inc'g	}	Couplings	-----	to -----	in. at	\$
			-----	\$		
Union	-----	in. at	-----	\$		
Meter	-----	in. at	-----	\$		
Lead Joints	-----	at	-----	\$		
Leadite Joints	-----	at	-----	\$		
Hrs. Foreman	-----	at	-----	\$		
Hrs. Chauffeur	-----	at	-----	\$		
Hrs. Tapper	-----	at	-----	\$		
Hrs. Labor	-----	at	-----	\$		
Hrs. Labor	-----	at	-----	\$		
Hrs. Compressor	-----	at	-----	\$		
Compensation Ins.	-----		-----	\$		
Trucking	-----		-----	\$		
Builders Use of Water	-----		-----	\$		
	-----		-----	\$		
	-----		-----	\$		
St. ~~25~~
 Ph
 Hudson Ave. No. 20

Name of Owner _____

Labor and Mat'l. Report 19

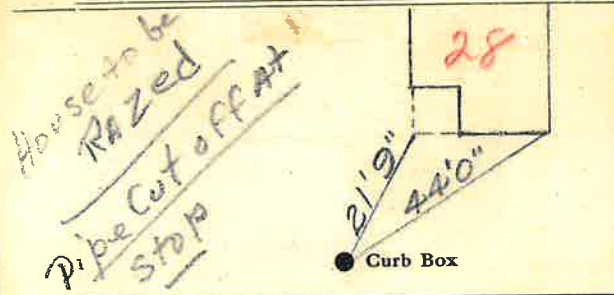

Main Elev. of
Main at tap

Gate at ● ● Gate at

● Curb Box

Shutoff at Curb 11-30-72