

29-148 **297136** 5/29 19

Labor and Material Report

3/4" Tap at 21' Hudson Ave

Pipes
297136
 4'-7 1/2"
 11'-6"
 Curb Box

Main Elev of Main at tap 4 1/2


Gate at ● ● Gate at

● Curb Box

Old tap disc

S.C. La Point

(4)

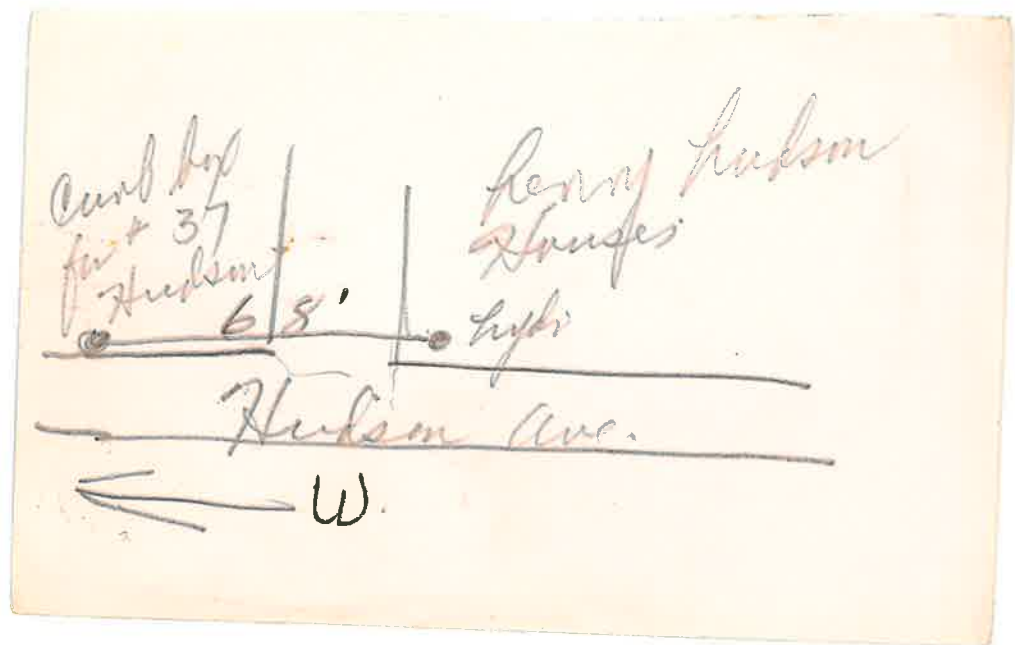

Labor and Materials

1	Copper } Connection	3/4"	\$ 2.60
	Lead		
1	Curb } Cock Valve	3/4" in	\$ 2.30
	T.S. & V.		
1	Service Box } Short 3 1/2 x 4 1/2		\$ 1.40
	Old returned } Long 4 1/2 x 5 1/2		
		Bull. or Rdway	
10	Pt. } in. } Copper		\$ 2.65
		Galv. Iron	
		Pipe at	
		Cast Iron	
	Nipples	in. at	\$
1	Bushings	3/4" to 1/2" in. at	\$ 1.0
	Red'g } Couplings	to in. at	\$
	Inc'g }		
	Union	in. at	\$
	Meter	in. at	\$
	Lbs. Br. Stone	at	\$
	Lbs. Sand	at	\$
	Bags Cement	at	\$
	Paving Brick } Mack		\$
		Red	
		Asphalt	
	Lead Joints	at	\$
	Leadite Joints	at	\$
	Hrs. Foreman	at	\$
2	Hrs. Common Labor	at Tapper	\$ 4.00
10	Hrs. Common Labor	at	\$ 4.06
	Hrs. Mason	at	\$
	Hrs. Mason's Helper	at	\$
	Hrs. Compressor	at	\$
	Compensation Ins		\$.13
	Trucking		\$ 1.00
	Builders' Use of Water	Patch	\$ 5.00
			Total \$ 20.24