
e 40	
Labor and Materials	1.1.1
	. 2.60
Lead	
Curb Valve	
(T.S. 8 V.)	s.1.50
L. Selvice 1 Done	
24. Ft. 34in. Copper Galv-tron Pipe at	\$\$?.????
	\$
Red'g Couplingstoin. at Inc'g Couplingstoin. at	
	\$
Lbs. Br. Stone at	
Lbs. Sand at	
Bags Cement 'at	
Paving Brick Mack Asphalt	\$
	\$
Leadite Joints at	
The Foreman at	
.Z. Hrs. Common Labor at. Tapper	e LaSD
16Hrs. Common Labor at	
Hrs Mason at	
Hrs Mason's Helper at	\$
Hrs. Compressor at	s
Compensation Ins	\$ 1.50
Trucking	s. 5.0R.
Builders' Use of Water	
1	Total \$ 26.56

....

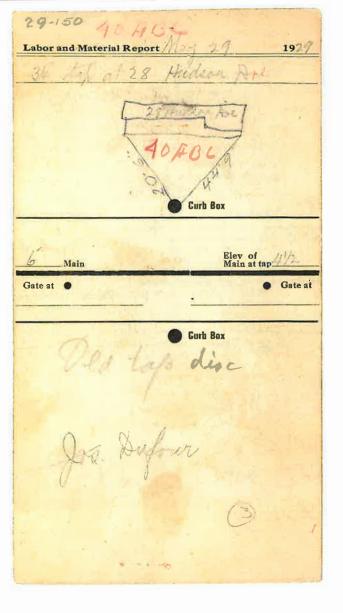

\*

20' 6" 44' 9"