


### Labor and Materials

1	Copper	Connection	3/4	\$ 2.60
	Lead			
1	Curb	Cock Valve	3/4 in.	\$ 2.30
		T.S. & V.		
	Service Box	Short	3 1/2 x 4 1/2	\$
	Old returned	Long	4 1/2 x 5 1/2	\$
		Buff. or Rdway		\$
70	Pt.	Copper	3/4 in.	\$ 2.65
		Galv. Iron		
		Cast Iron	Pipe at	
	Nipples		in. at	\$
1	Bushings	3/4 to 1/2	in. at	\$ 1.0
	Red'g Inc'g	Couplings	to in. at	\$
	Union		in. at	\$
	Meter		in. at	\$
	Lbs. Br. Stone		at	\$
	Lbs. Sand		at	\$
	Bags Cement		at	\$
	Paving Brick	Mack Red Asphalt	at	\$
	Lead Joints		at	\$
	Leadite Joints		at	\$
	Hrs. Foreman		at	\$
2	Hrs. Common Labor	Tapper		\$ 1.00
4	Hrs. Common Labor			\$ 1.60
	Hrs. Mason		at	\$
	Hrs. Mason's Helper		at	\$
	Hrs. Compressor		at	\$
	Compensation Ins			\$ .07
	Trucking			\$ 1.50
	Builders' Use of Water	Patch		\$ 5.00

Total \$ 16.35

The tap at 31 Hudson Ave

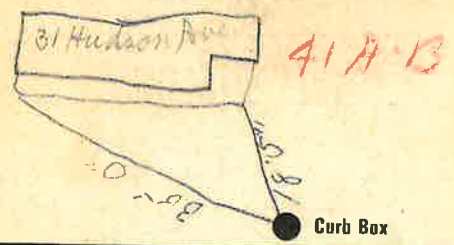

6" Main Eley of Main at tap 4 1/2  
Gate at ● Gate at ●

● Curb Box

Des tap disc.  
Eugene Blackburn  
Shut OFF H-1 Curb