

Labor and Materials


1	Copper } Connection		\$ 3.20
	Lead }		
1	Curb { Cock		
	Valve }		
	P. S. & V. }	in.	\$ 1.00
1	Service Box { Short 3" x 4"		
	Old returned { Long 4" x 5"		
		Buff. or Rdway }	\$ 1.30
26	Ft. in. { Copper		
		Galv. Iron }	
		Cast Iron }	
		Pipe at.	\$ 5.72
	Nipples	in. at.	\$
	Bushings	to. in. at.	\$
	Red'g } Couplings	to. in. at.	\$
	Inc'g }		
	Union	in. at.	\$
	Meter	in. at.	\$
	Lbs. Br. Stone	at.	\$
	Lbs. Sand	at.	\$
	Bags Cement	at.	\$
	Paving Brick { Mack		
		Red }	
		Asphalt }	
	Lead Joints	at.	\$
	Leadite Joints	at.	\$
1	Hrs. Foreman	at. 6 2/2	\$ 6.3
1	Hrs. Common Labor	at. 4 1/8	\$ 4.1
	Hrs. Common Labor	at.	\$
	Hrs. Mason	at.	\$
	Hrs. Mason's Helper	at.	\$
	Hrs. Compressor	at.	\$
	Compensation Ins.		\$ 0.3
	Trucking		\$ 1.00
	Builders' Use of Water		\$
Total \$			

Street number?

Labor and Material Report

19

East Hunter St.

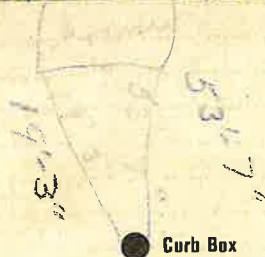

Main

Elev. of
Main at tap

Gate at

Gate at

Curb Box

draw house
new top