

Labor and Materials

1	Copper } Connection	3/4"	\$ 1.25
1	Lead } Connection	3/4"	\$ 1.70
1	Curb { Cock Valve T.S.&V. }	3/4" In	\$ 1.70
1	Service Box { Short 3 1/2 x 4 1/2 Long 4 1/2 x 5 1/2 Buff. or Railway }		\$ 1.45
13	Ft. 3/4 in. { Copper Galv. Iron Cast Iron } Pipe at B. 1/2 in.		\$ 1.76
	Nipples	in. at	\$
1	Bushings	3/4" to 1/2" in. at	\$.05
	Red'g Inc'g } Couplings	to in. at	\$
	Union	in. at	\$
	Meter	in. at	\$
	Lbs. Br. Stone	at	\$
	Lbs. Sand	at	\$
	Bags Cement	at	\$
	Paving Brick { Mack Red Asphalt }	at	\$
	Lead Joints	at	\$
	Leadite Joints	at	\$
5	Hrs. Foreman	62 1/2	\$ 2.13
1	Hrs. Common Labor	50	\$.50
5	Hrs. Common Labor	45	\$ 2.25
	Hrs. Mason	at	\$
	Hrs. Masons Helper	at	\$
	Hrs. Compressor	at	\$
	Compensation Ins		\$.22
	Trucking		\$ 1.-
	Builders Use of Water		\$

Total \$13.31


1935-10

13

Labor and Material Report

1935

3/4 tap at 11' center at

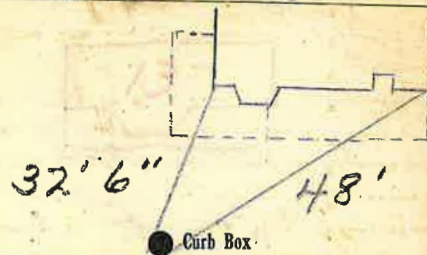

4" Main

Elev. of Main at tap 41/2

Gate at TAX ID # 302.16-15-17

Gate at

Curb Box

Old tap shut off at main

FROM

G.K. Porch

(Signature)

L - 21' 10"

R - 43' 4"